THIS MAP WAS PREPARED FOR ASSESSMENT PURPOSE ONLY.

SECTION 10 T.41S. R.11E. W.M.
KLAMATH COUNTY

1"=400'

SEE MAP 41 11 03

41 11 10

RECEIVED
JAN 14 2002
WATER RESOURCES DEPT
SALEM, OREGON

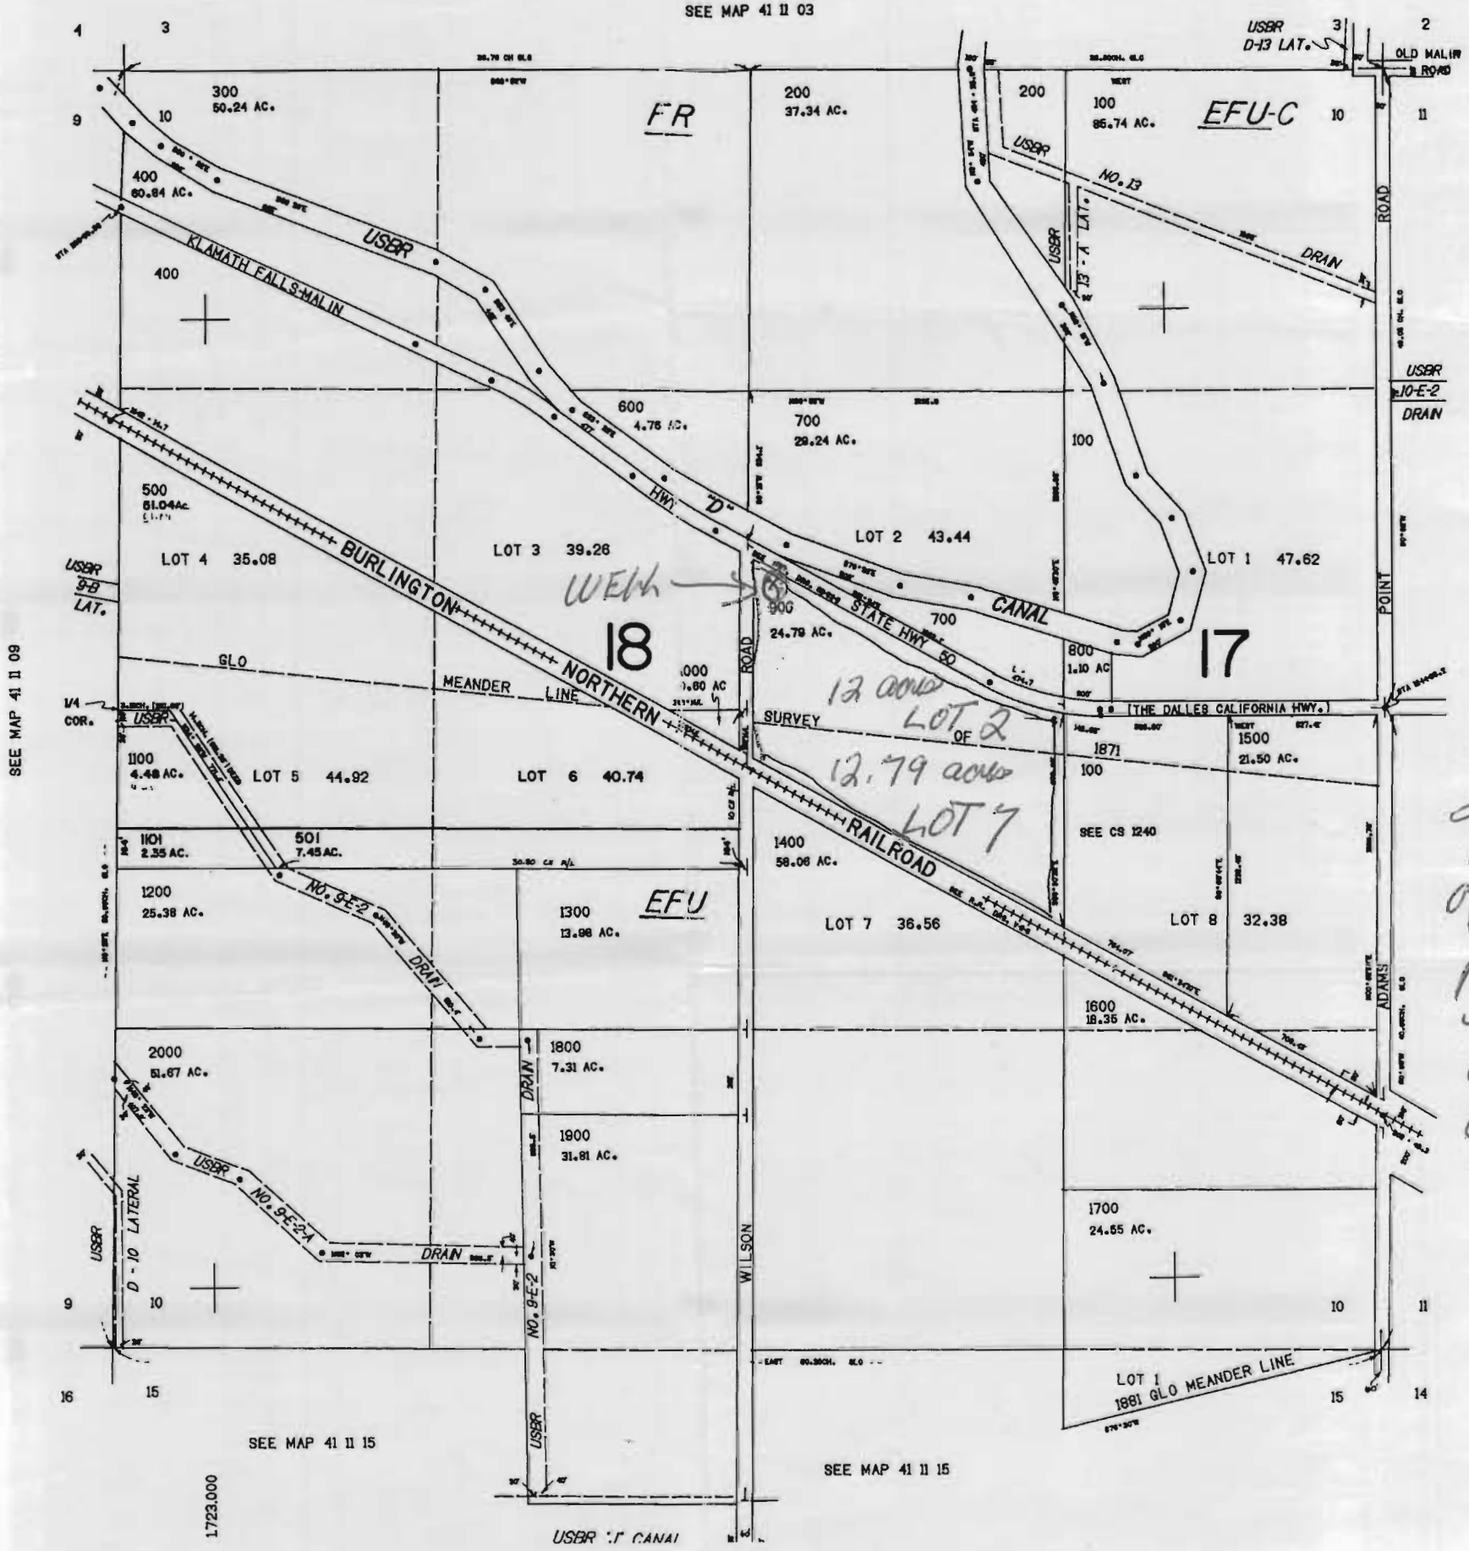

WEH

12 acres LOT 2
12.79 acres LOT 7

Application No. G-15514
Permit No. G-15177

Dear Sir;
The Meander line of 1871 divides my property almost evenly in half. This is according to Klamath County Surveyors office.

Thanks
Doug Boggs
1-10-2002

41 11 10