

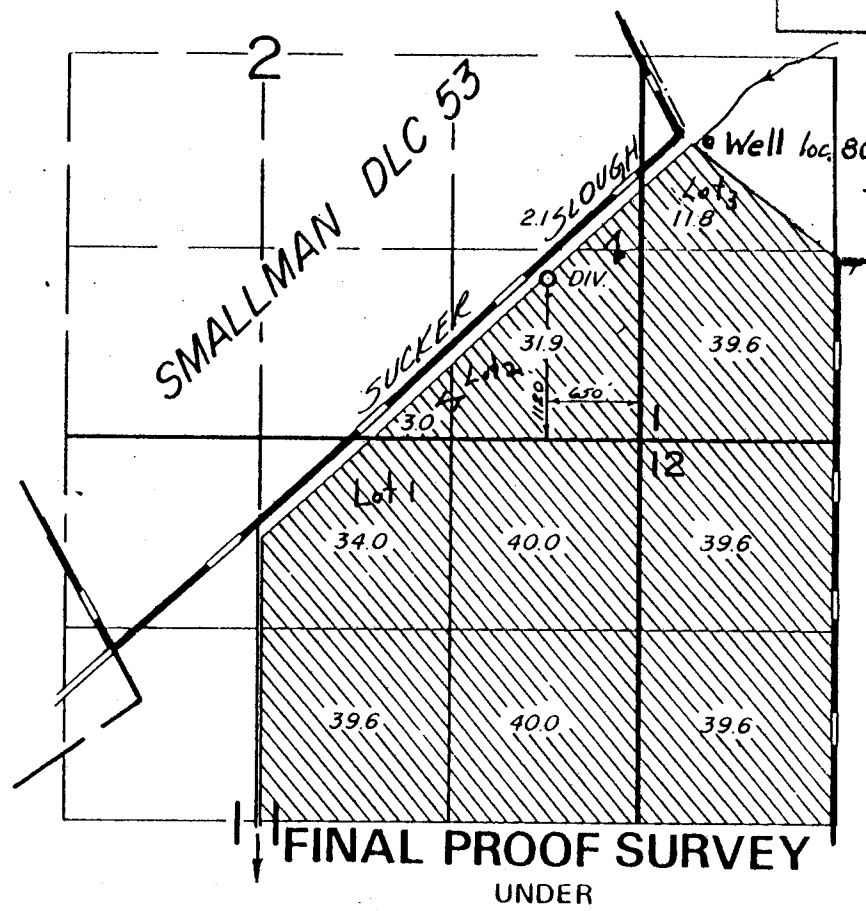


T. 10S., R. 2W., W.M.

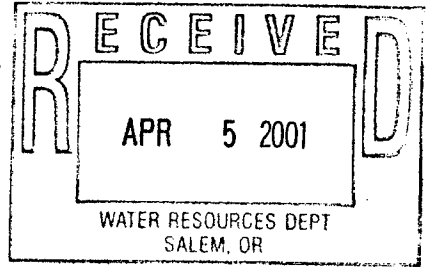

Well loc. 80'S. & 160'E From SE COR. DLC 53

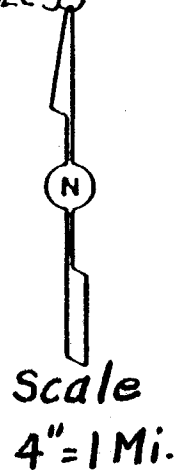

Application No. 49887 53989 Permit No. 37753 40260

WATER RIGHT APPLICATION MAP FOR Mt. JEFFERSON FARMS

THIS MAP WAS PREPARED FOR THE PURPOSE OF IDENTIFYING THE LOCATION OF A WATER RIGHT ONLY AND IS NOT INTENDED TO PROVIDE LEGAL DIMENSIONS OR LOCATION OF PROPERTY OWNERSHIP LINES.

Application No. 915463 Permit No. 6-15178

