

LOCATION of well to be  
Approx: 740'S ± 2,240'E  
from NW corner Section 8

**RECEIVED**


MAY 17 2001

WATER RESOURCES DEPT  
SALEM, OREGON

**SECTION 8 T1S R2W W.M.**

WASHINGTON COUNTY OREGON

SCALE 1"=400'

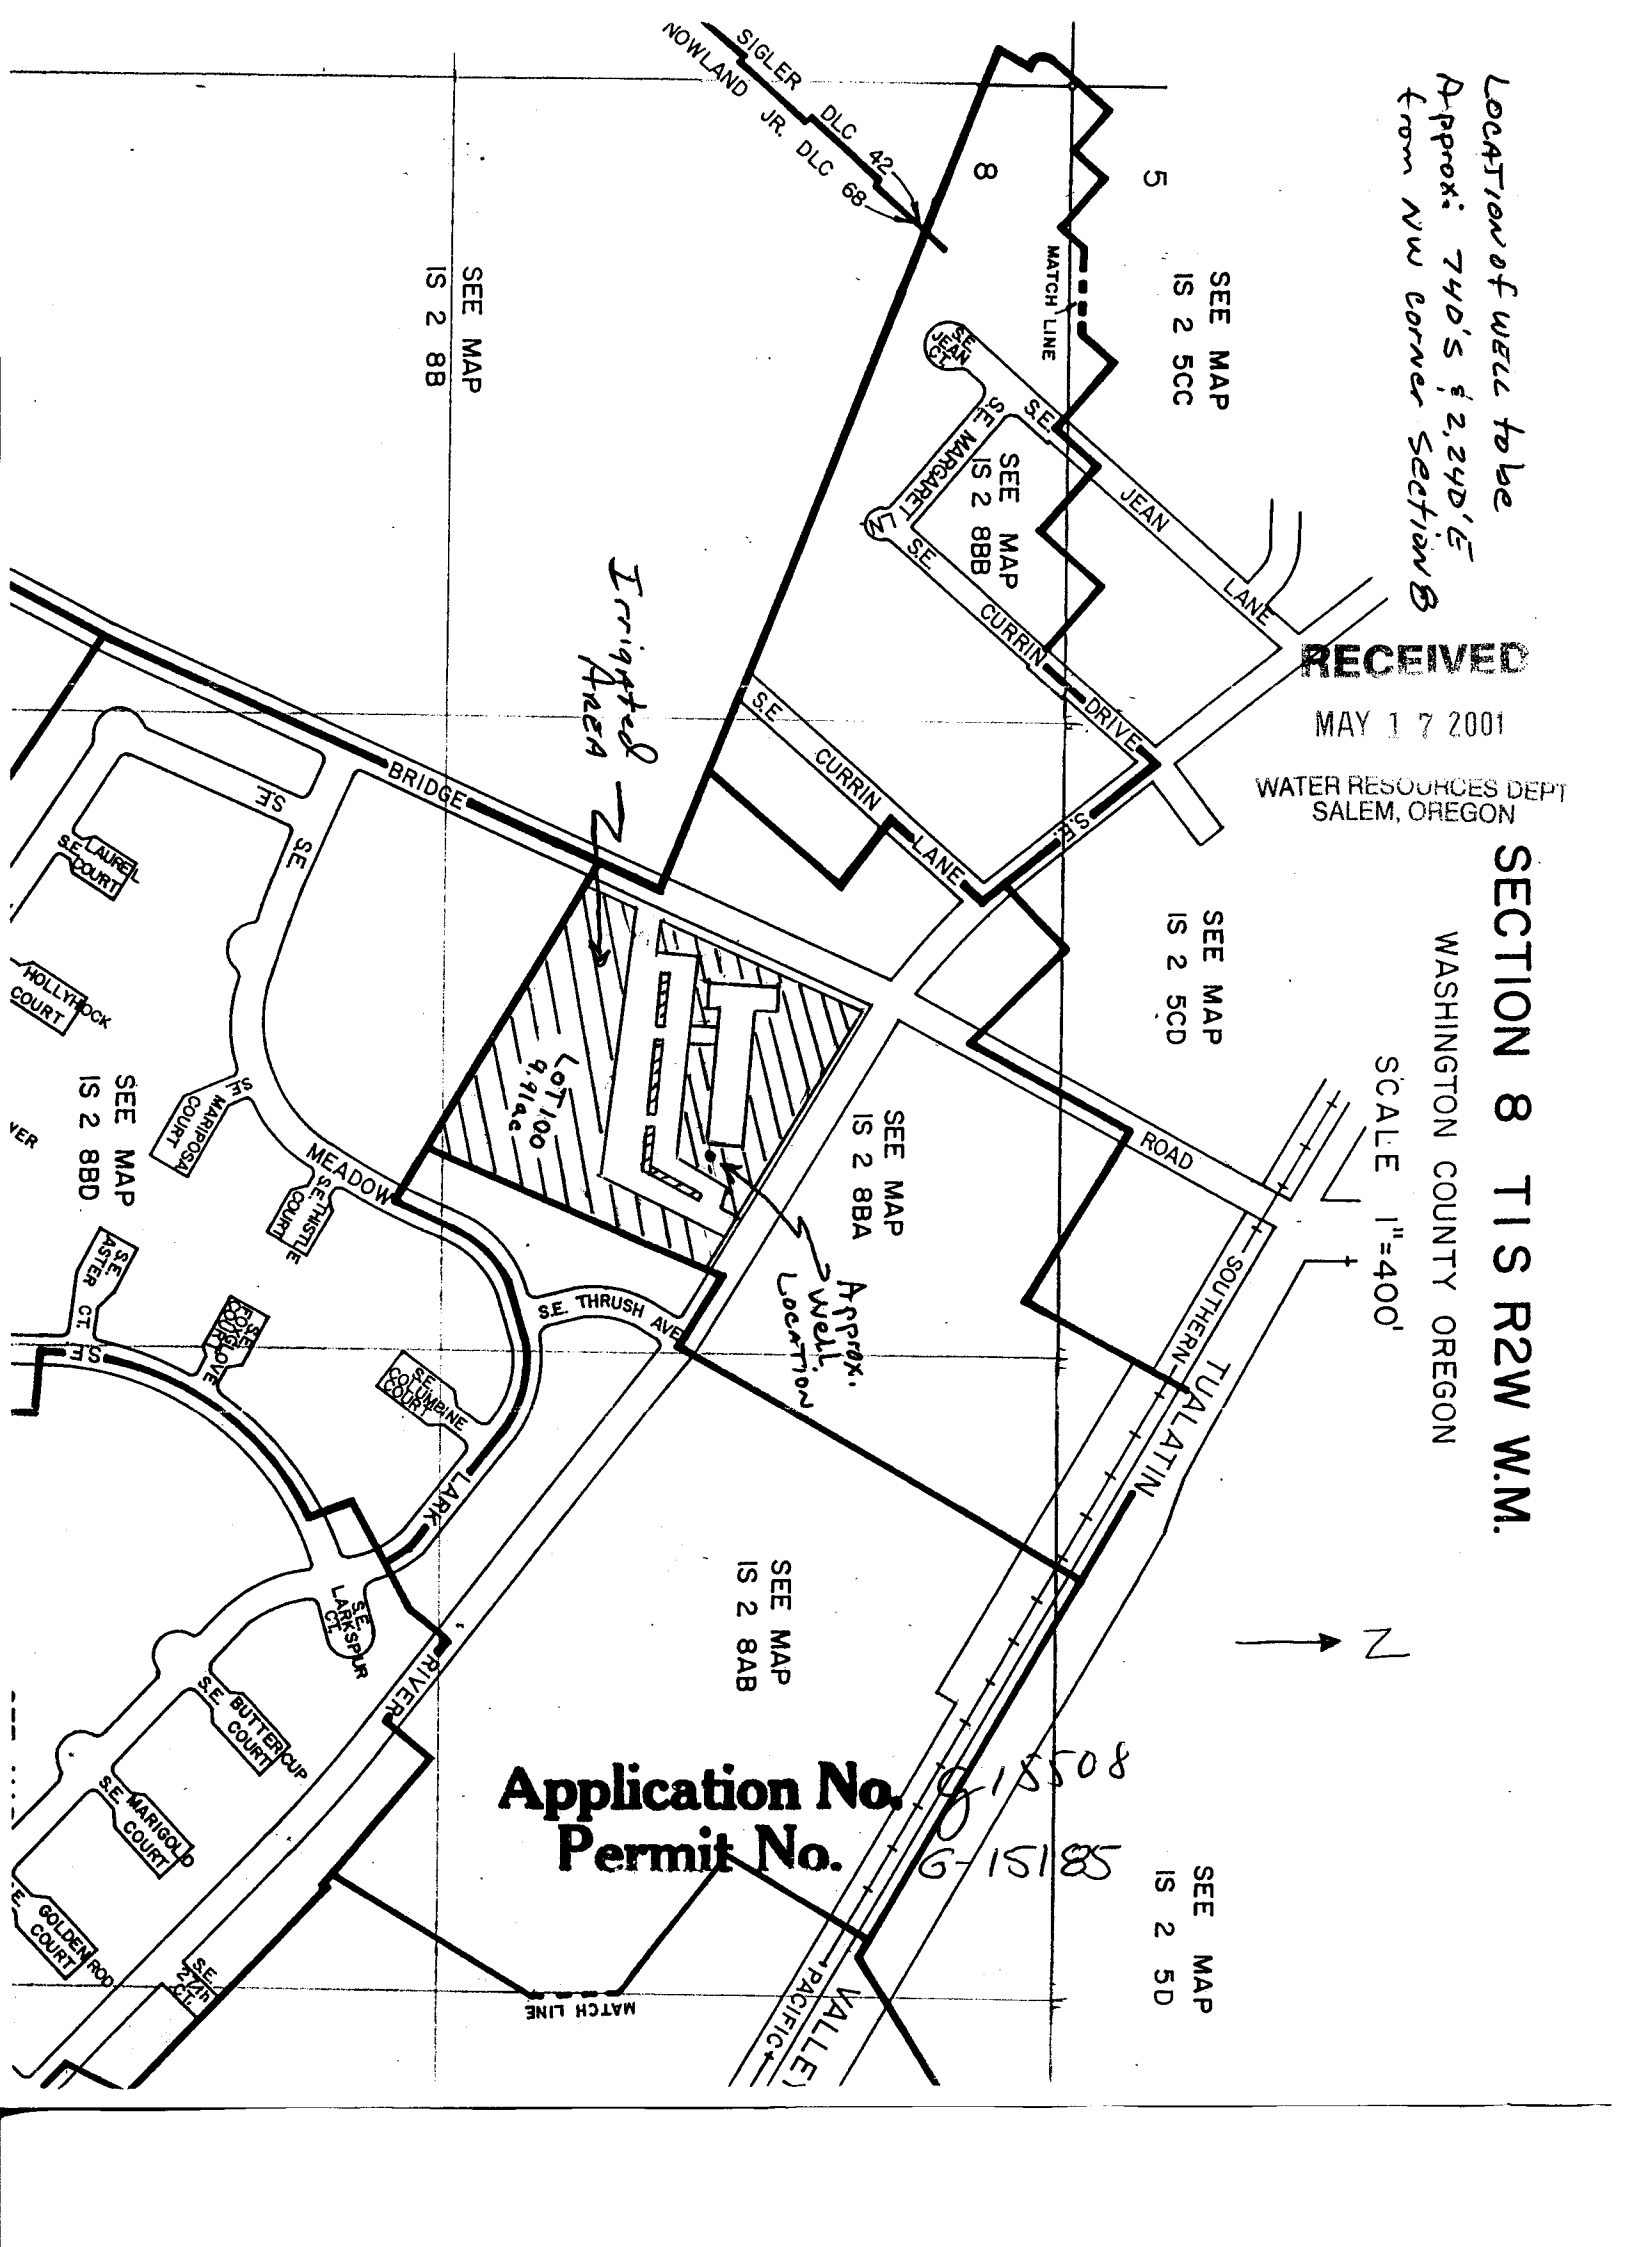

**Application No. 8-15508**  

SEE MAP  
IS 2 8AB

SEE MAP  
IS 2 5D

SEE MAP  
IS 2 5CD

SEE MAP  
IS 2 8BA

SEE MAP  
IS 2 5CC

8

5

SEE MAP  
IS 2 8B

SEE MAP  
IS 2 8BD


























