


RECEIVED

JUN 18 2001

WATER RESOURCES DEPT.
SALEM, OREGON

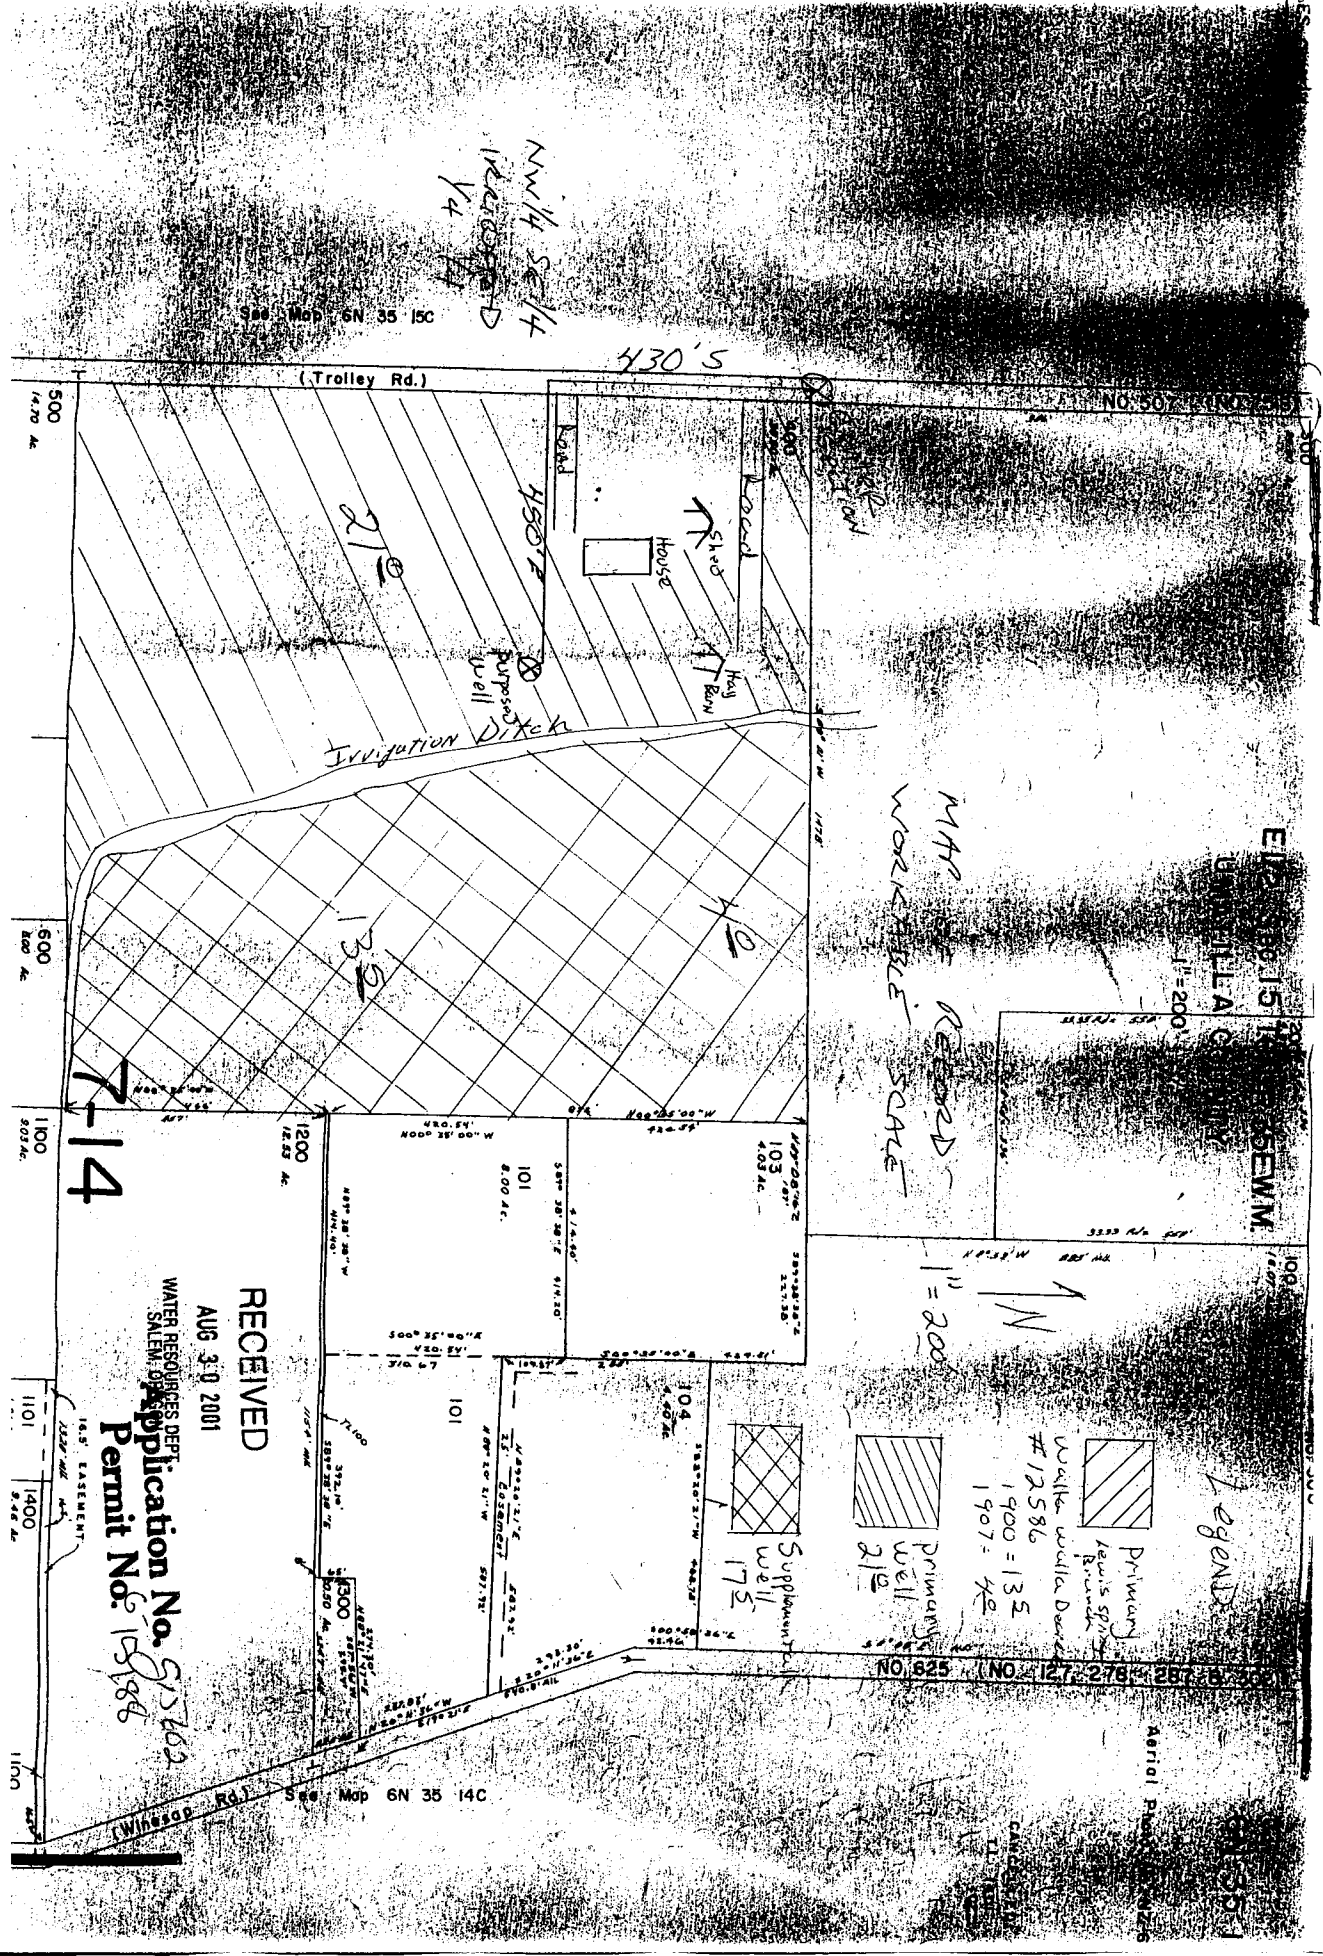

NW 1/4 SE 1/4
1/4
1/4

See Map 6N 35 15C

430'S

(Trolley Rd.)

NO. 50

500
1470 Ac

600
807 Ac

1100
507 Ac

1101
846 Ac

1100
846 Ac

7-14

RECEIVED
AUG 30 2001

WATER RESOURCES DEPT.
SALEM, OREGON
Application No. 515602

See Map 6N 35 14C

MMP RECORD
WORK SHEET SCALE

1" = 200'

Legend

- Primary Well
- Supplemental Well

#12586
1900 = 135
1907 = 42

Aerial Photo