SOUTH 1/2 SECTION 35
TOWNSHIP 6 NORTH, RANGE 35 EAST, W.M.

RECEIVED
JUN 2 9 2001
WATER RESOURCES DEPT.
SALEM, OREGON

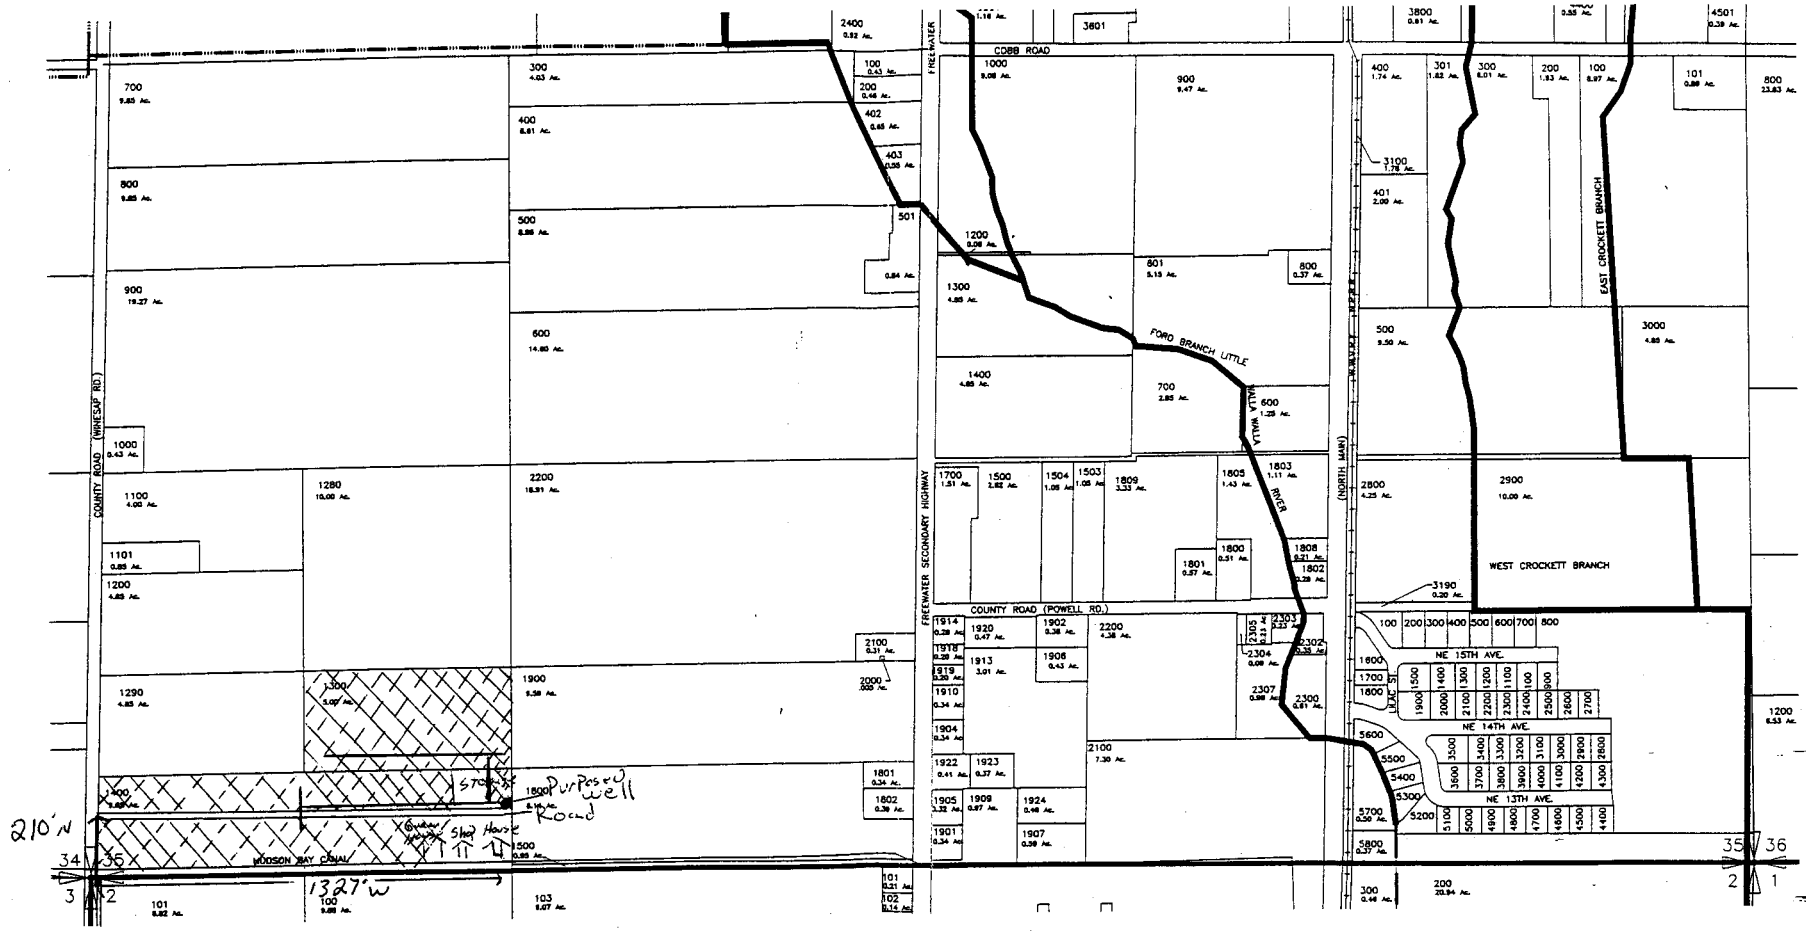

Primary Hudson Bay
7¹ Acres Cert# 27021
5⁰ Acres Permit# 43973

13² Supp. from new well

Application No. S-15554
Permit No. G-15193

0 200 400
SCALE IN FEET

DWG 35S

WALLA WALLA RIVER IRRIGATION DISTRICT

SCM Consultants, Inc. Architects & Engineers Kennewick, WA 99336

4376.015 4376-35S.DWG 11/29/00