


MAP OF THE PROPERTY OF ARTIE OWINGS LOCATED
IN SEC. 1, T. 5 S., R. 1 W., W. M. CLACKAMAS COUNTY OREGON
FOR WELL AND IRRIGATION PERMITS.

SCALE 1 INCH = 400 FEET

////// INDICATES LAND TO BE IRRIGATED

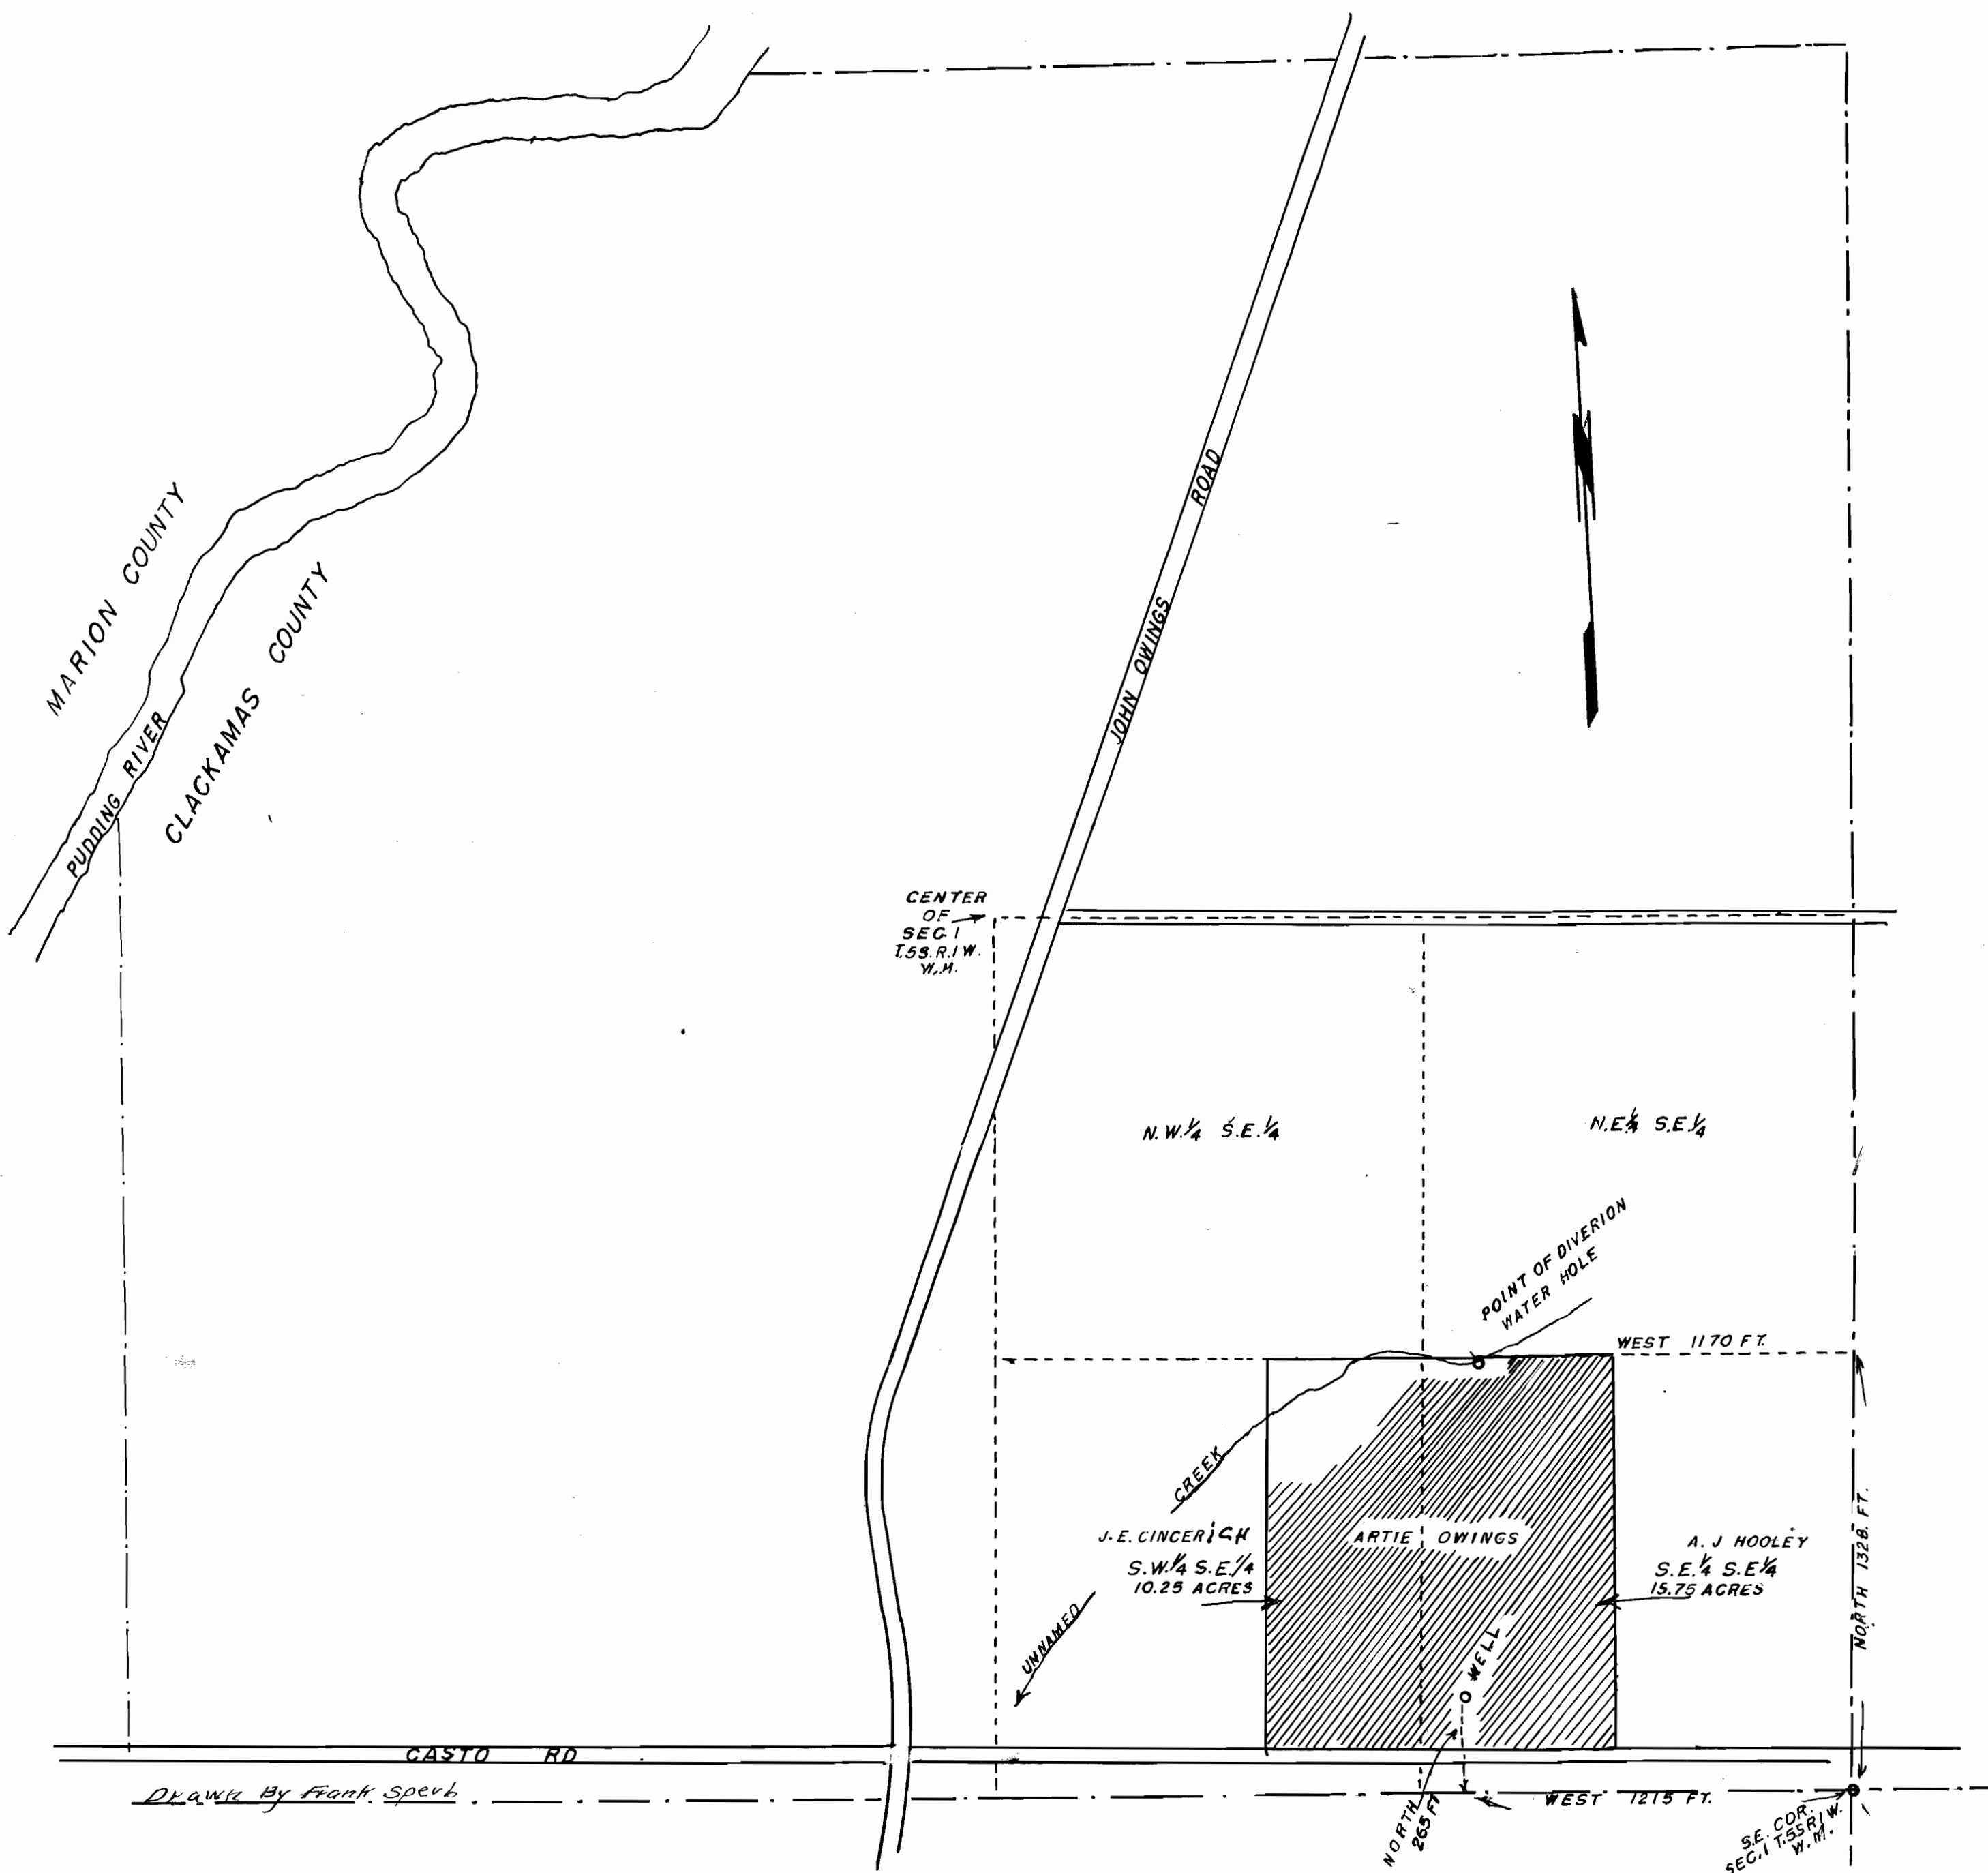

G-251

G-152