


SECTION 20 T5S R6W W.M.
YAMHILL COUNTY
1" = 400'

FILE COPY

SEE MAP 5 6 17

17	16
20	21

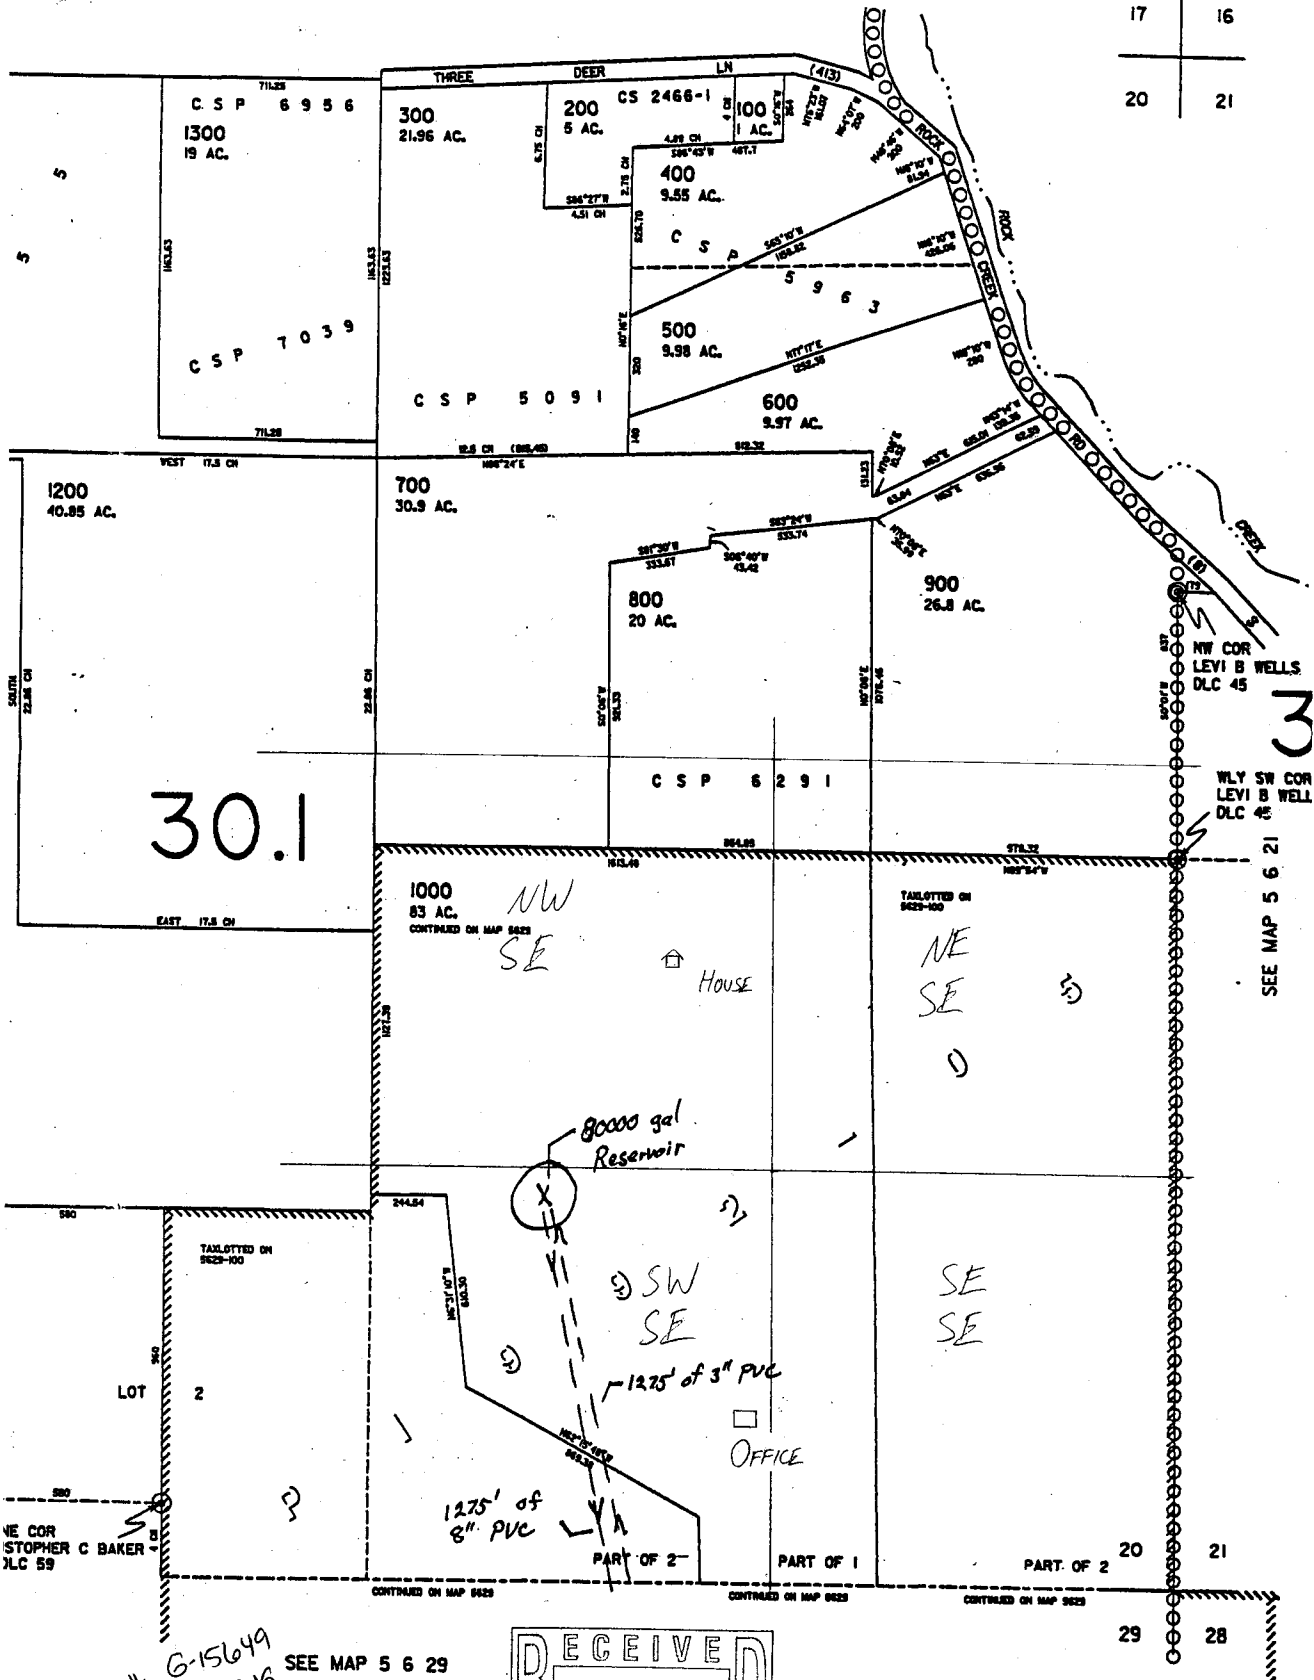

1/4 COR STOPHER C BAKER JLC 59


APP# 6-15649
Permit # 6-15219
SEE MAP 5 6 29

RECEIVED
JUL 8 2002
WATER RESOURCES DEPT
SALEM, OR

SECTION 28 T.5 S. R.6 W. WM.

YAMHILL COUNTY

1" = 400'

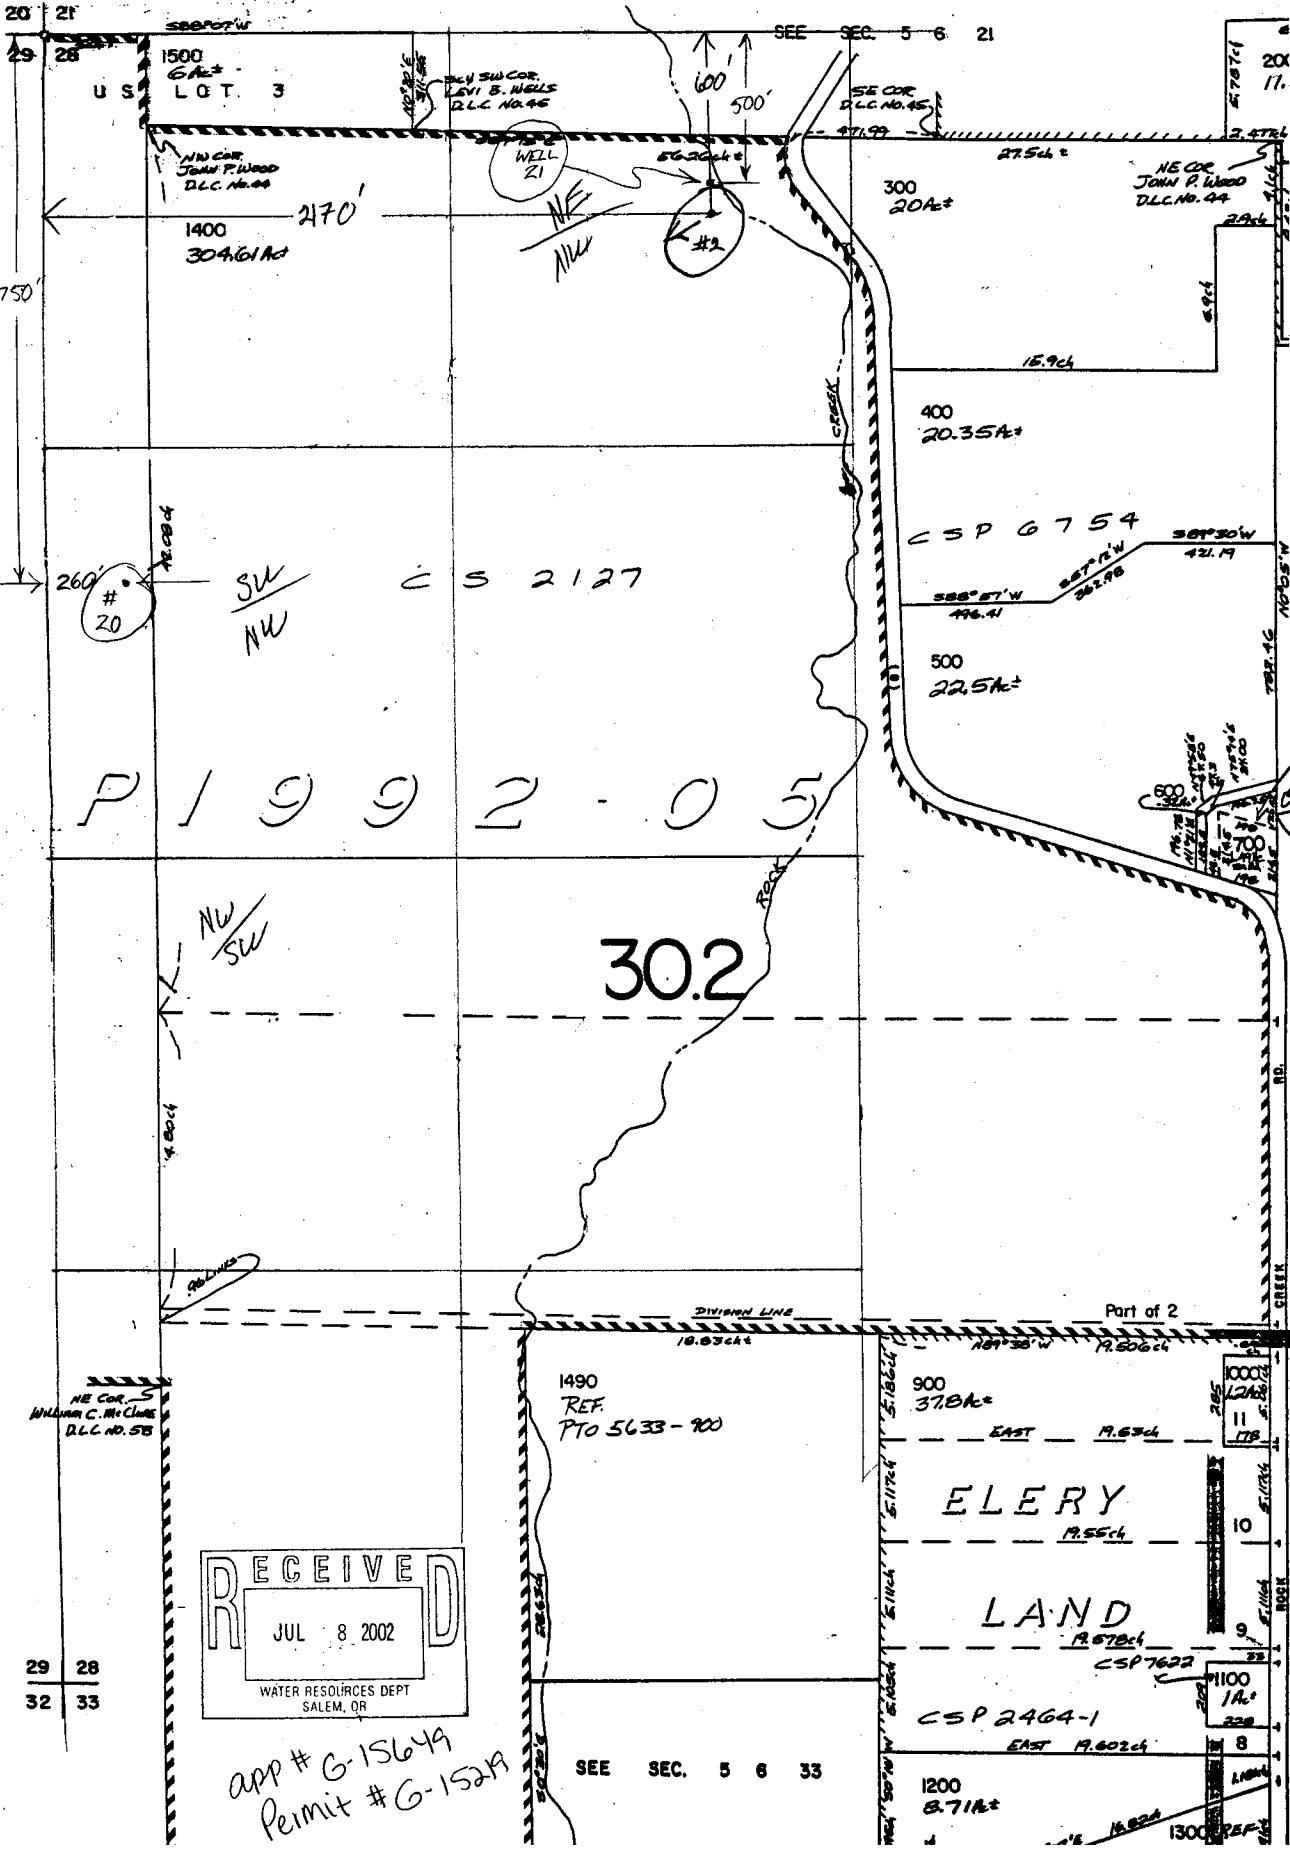

RECEIVED
 JUL 8 2002
 WATER RESOURCES DEPT
 SALEM, OR

app # G-15649
 Permit # G-15219

SEE SEC. 5 6 33

29 28
 32 33

20
 11.

1000
 12A±
 11
 17B

1100
 1A±
 22B

1300 REF

ELERY
 LAND
 CSP 2464-1

1490
 REF.
 PTO 5633-900

900
 37.8A±

1200
 8.71A±

1500
 6A±
 LOT 3

1400
 304.61A±

300
 20A±

400
 20.35A±

500
 22.5A±

NE COR
 JOHN P. WOOD


SW COR.
 LEVI B. NIELLS
 D.L.C. NO. 45

SE COR
 D.L.C. NO. 45

NE COR.
 WILLIAM C. MCCLURE
 D.L.C. NO. 58


SW
 NW
 #20

NW
 SW

C S 2127

C S P 6754

388° 27' W
 196.41

309° 30' W
 421.19

327° 19' W
 261.98

105° 5' W
 105.5







DIVISION LINE
 18.83A±

Part of 2

187° 38' W
 19.806A±

EAST
 19.83A±

EAST
 19.55A±

EAST
 19.87A±

CSP 7622

EAST
 19.602A±

16.82A±

27.5A±

27.5A±

15.9A±








2170'

600
 500'

56.20A±











