

6-15673

Application No. Permit No. G-15218

DISTRICT/CITY JOINT DEVELOPMENT
ALAMEDA ELEMENTARY SCHOOL SITE
SCHOOL DISTRICT 8C
ONTARIO, OREGON





RECEIVED
DEC 24 2001
WATER RESOURCES DEPT
SALEM, OREGON

LEGAL DESCRIPTION

as follows:
Sec. 8, S1/2 NE1/4 NW1/4 SW 1/4 and SE 1/4 NW1/4 SW1/4,
EXCEPTING THEREFROM a strip of land 25 feet wide being
reserved and set apart as a part of a 50 foot roadway, and
rights of way for roads and ditches previously granted

WELL LOCATIONS:

#1 - 905' N. x 590' W. ;
#2 - 40' N. x 70' W., both
from the SE COR. NW1/4 SW 1/4
Section 9.

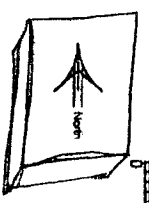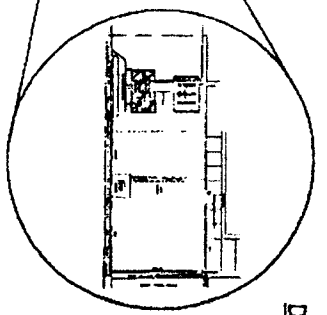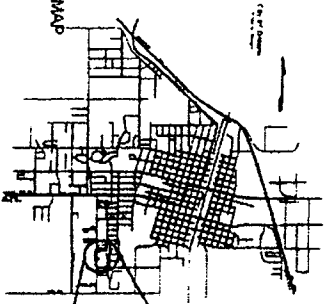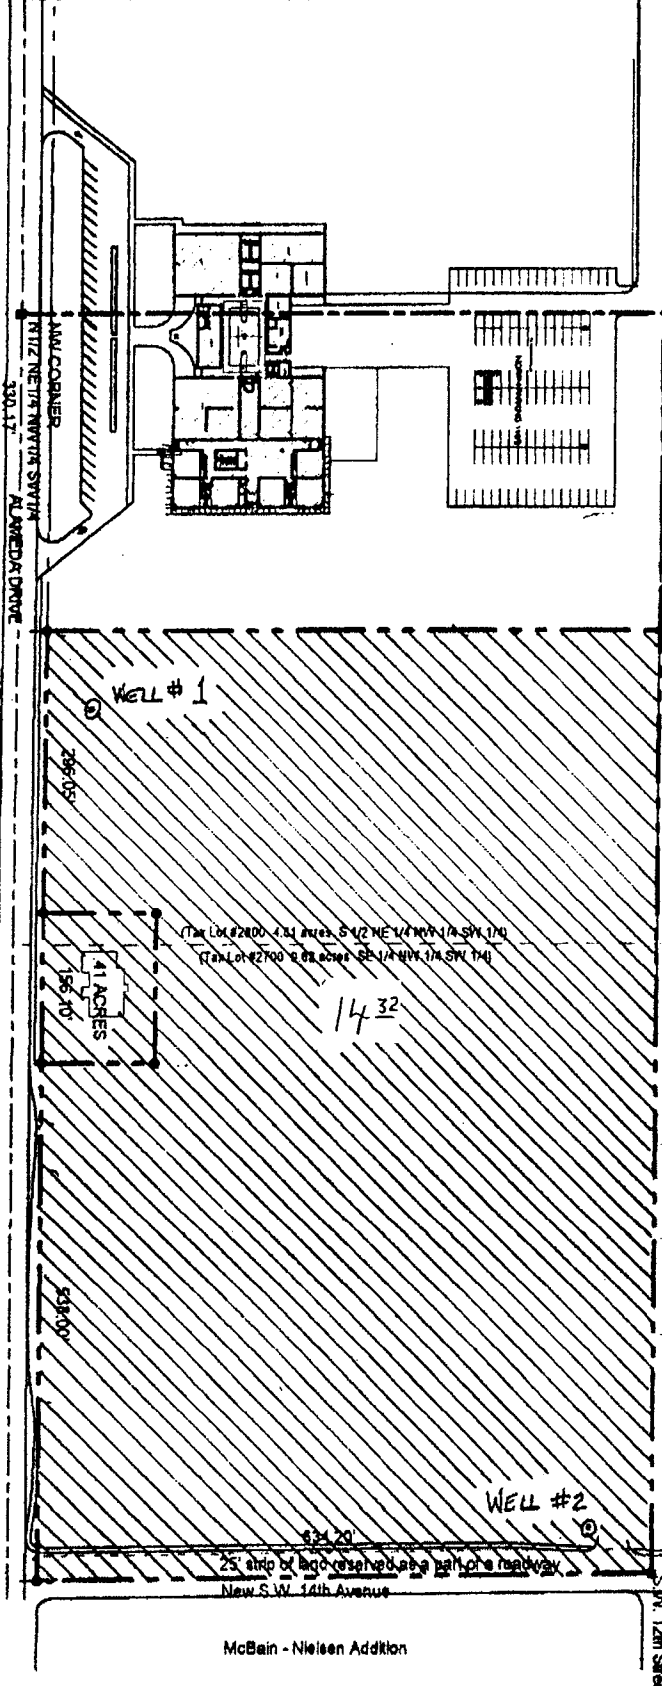

DEVELOPMENT SITE PLAN



EXHIBIT A