


MAP TO ACCOMPANY APPLICATION  
IN THE NAME OF  
D. WELLS INVESTMENTS, LLC.

RECEIVED  
DEC 19 2001  
WATER RESOURCES DEPT.  
SALEM, OREGON

T. 4 S., R. 2 W., W.M.  
NE 1/4 Sec. 36

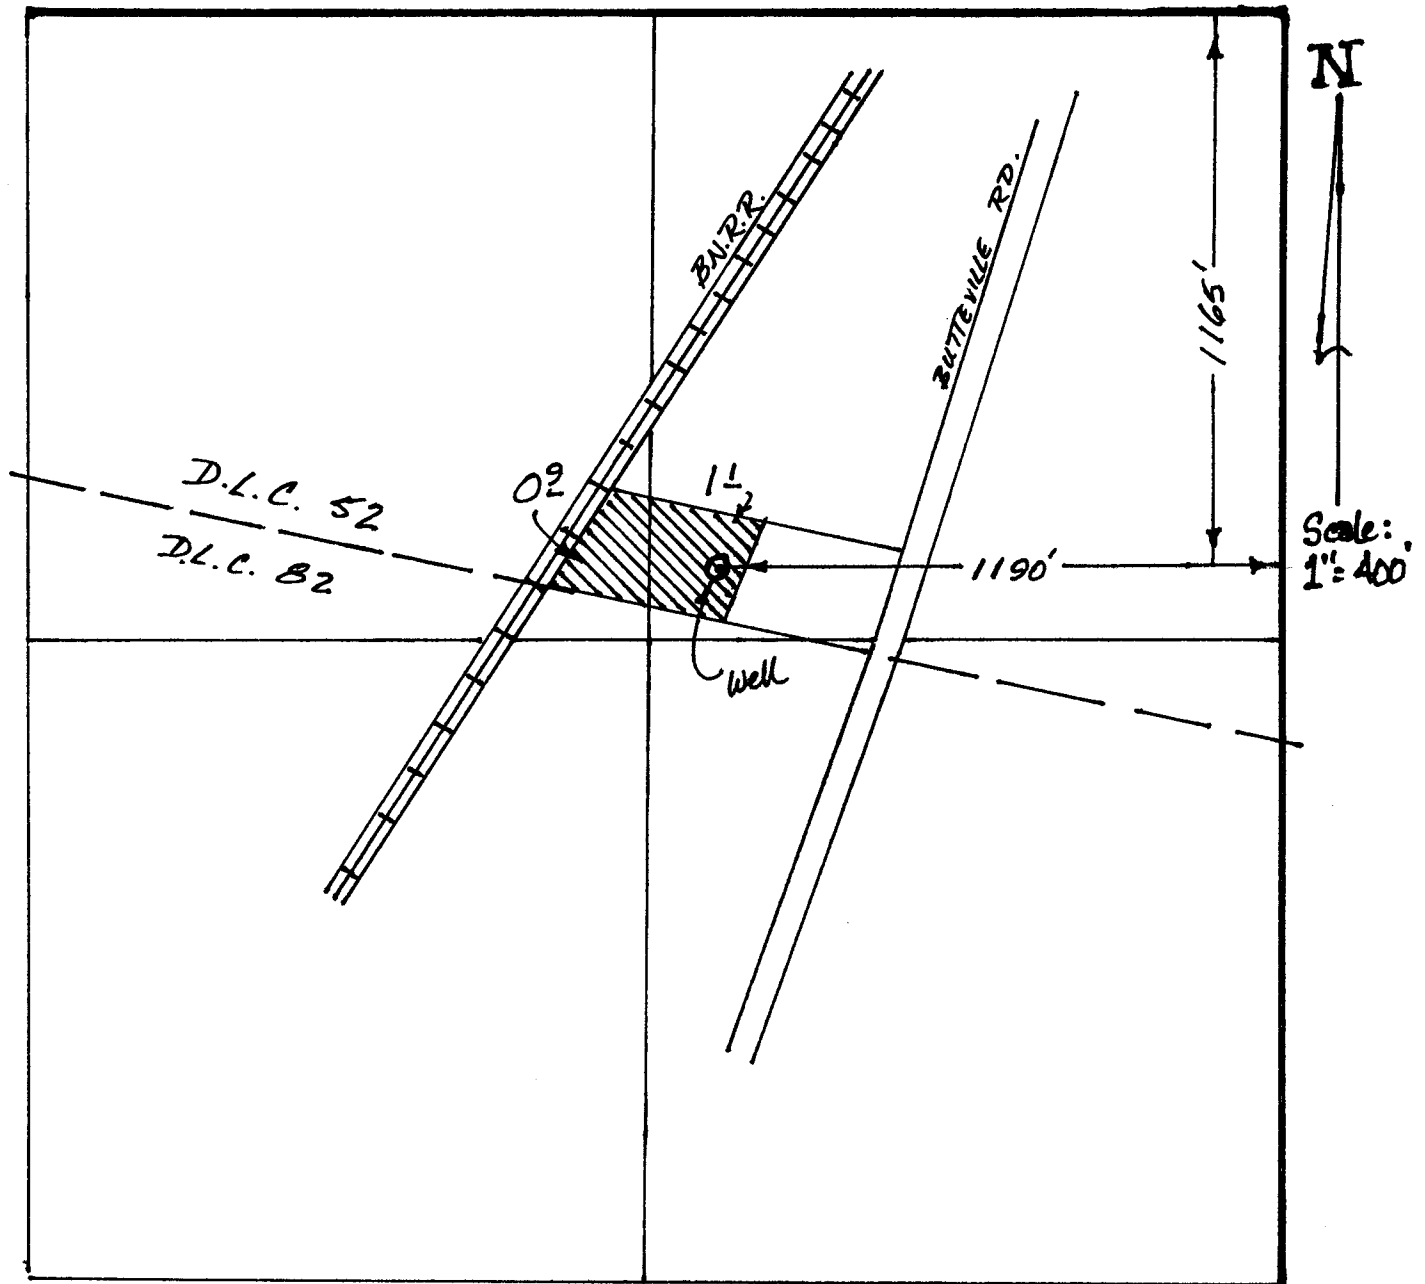

Application No. G-15671  
Permit No. G-15221

*AW*