


PLATE 2

Attachment 3

McNULTY WATER ASSOCIATION PLANNING AREA and P.O.U.

SCALE: 1" = 3000'

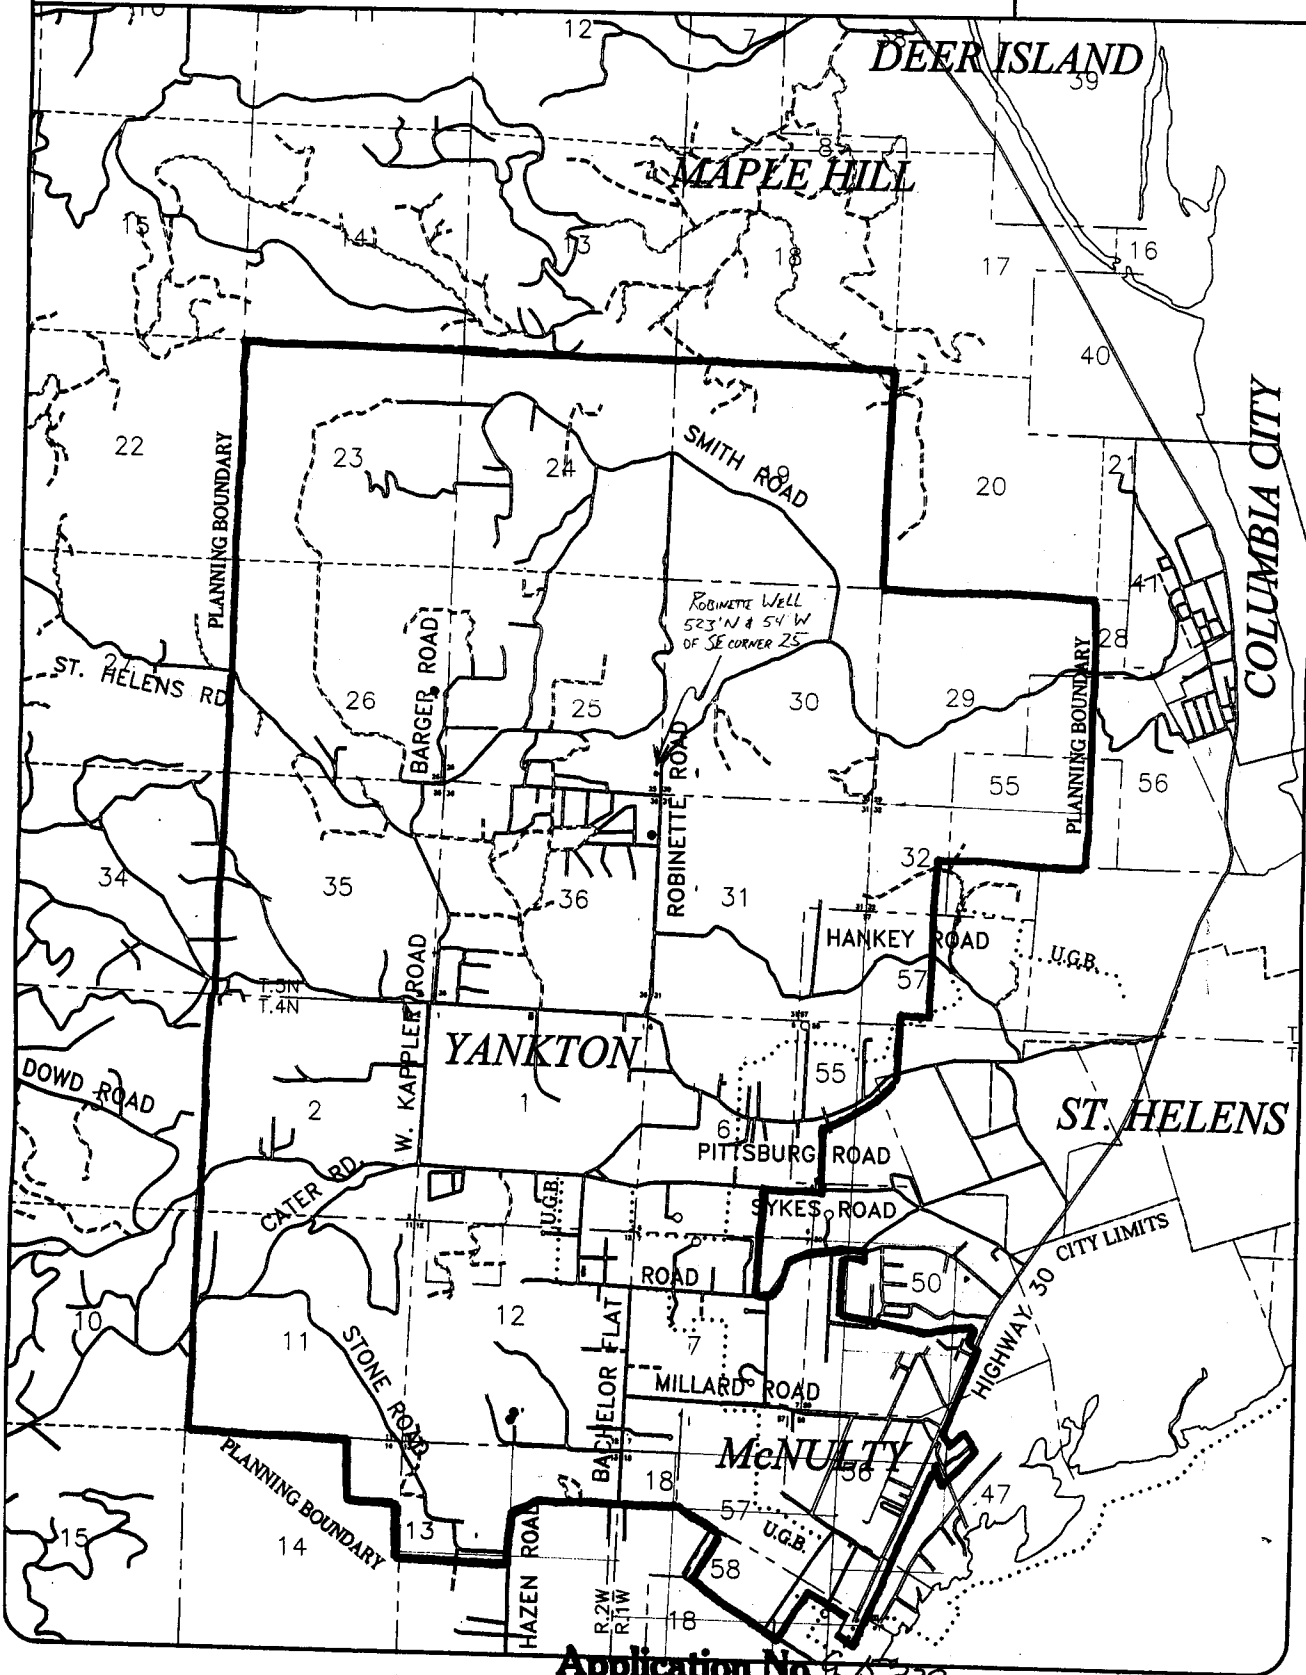

Application No. 7-15-279
Permit No. 6-15227