

SEP 28 2001


WATER RESOURCES DEPT.
SALEM, OREGON

SECTION 33 T.39S. R.09E. W.M.
KLAMATH COUNTY

1" = 800'

39 09 3
& INDE

THIS MAP WAS PREPARED FOR
ASSESSMENT PURPOSE ONLY.

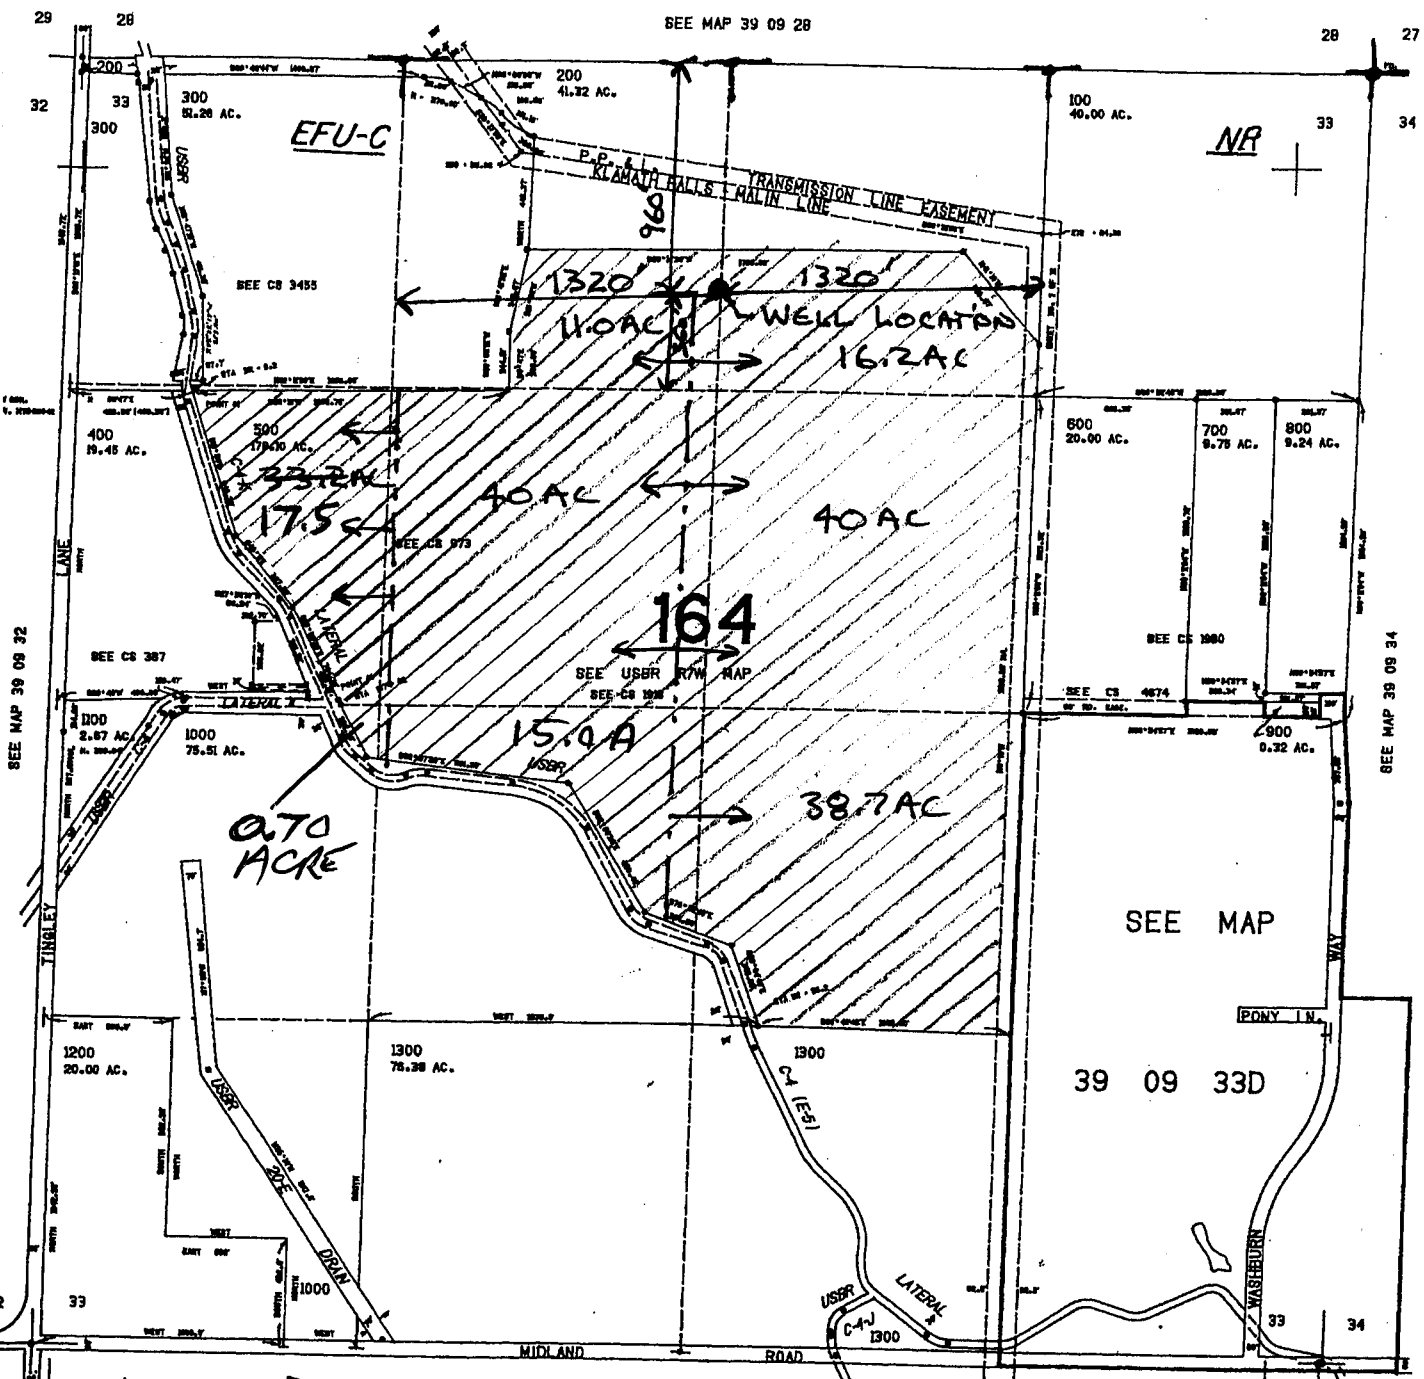

LEGEND

- +— SECTION CORNER
- ▨ AREA OF USE
- PROPOSED IRRIGATION WELL
- 8" MAIN LINE IRRIGATION
- WHEEL LINE LOCATIONS

Application No. 915620³
Permit No. 915235

↑ NORTH
1" = 800'

39 09 33
& INDEX

1554.000

170.000