


T 1 S R 17 E

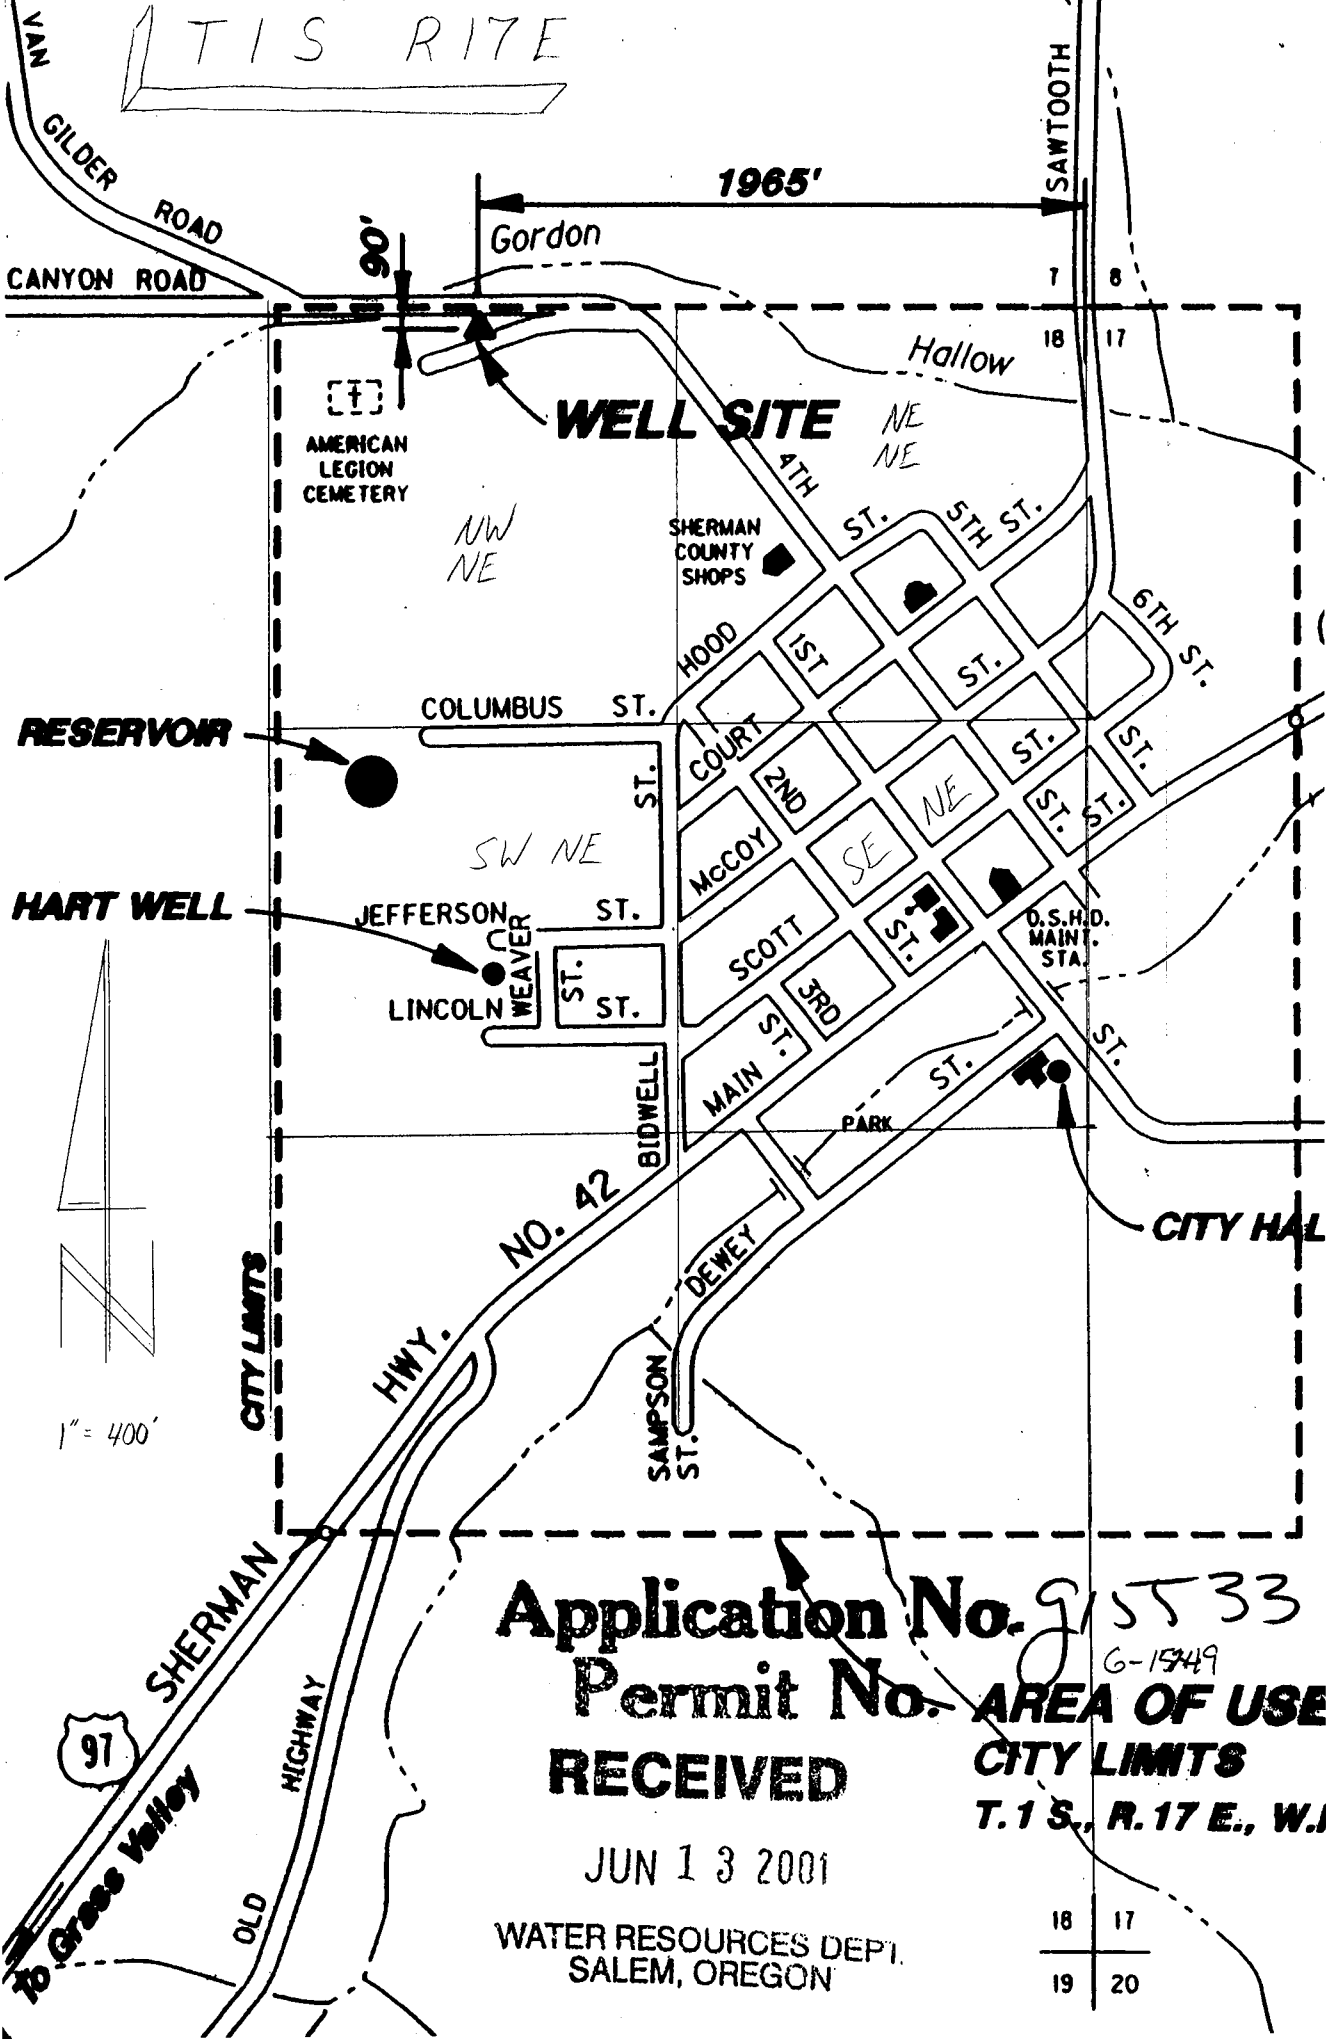

Application No. 91533

Permit No. 6-1549

RECEIVED

AREA OF USE  
CITY LIMITS  
T.1 S., R.17 E., W.1

JUN 13 2001

WATER RESOURCES DEPT.  
SALEM, OREGON

18	17
19	20