

# Ground Water Application Map For: KENNETH AND GRACE TORKELSON

**RECEIVED**

APR 13 2001

WATER RESOURCES DEPT.  
SALEM, OREGON


**RECEIVED**

MAR 27 2001

WATER RESOURCES DEPT.  
SALEM, OREGON

BUCHANAN LANE

GEKELER LANE

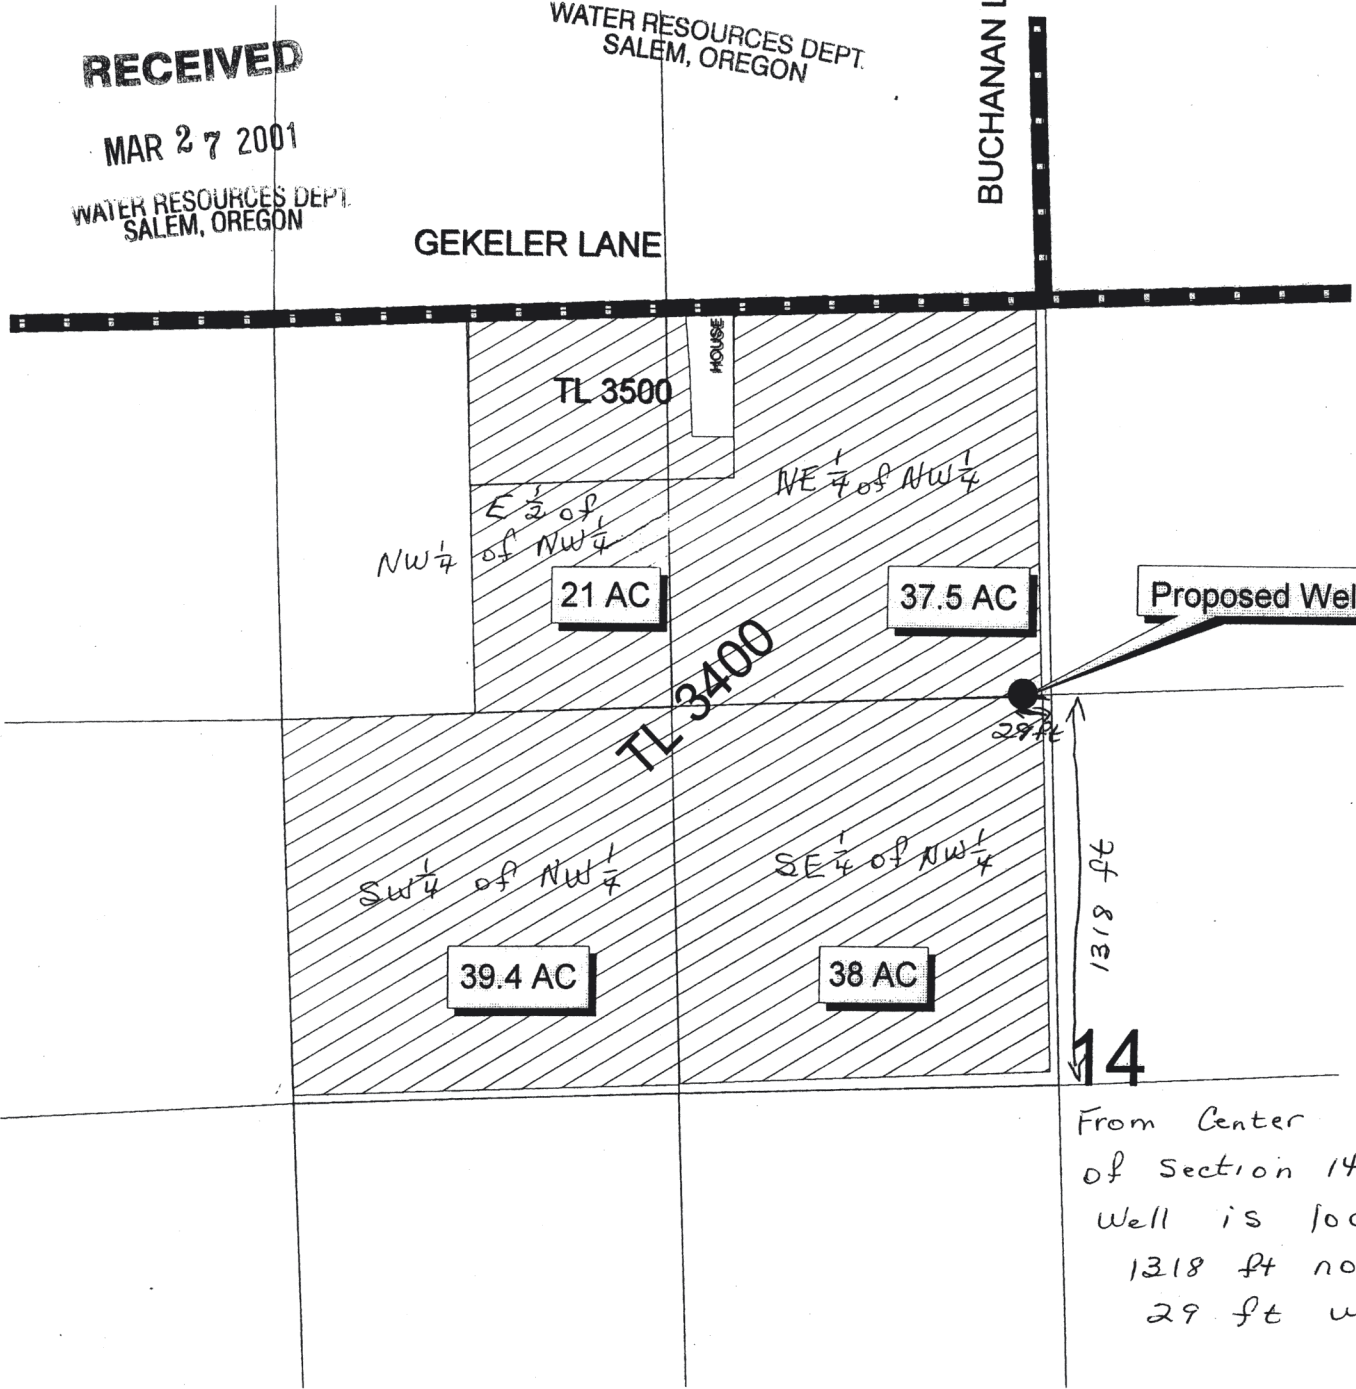

Proposed Well

29 ft  
1318 ft

14

From Center  
of Section 14  
Well is located  
1318 ft north  
29 ft west

Township 3 South, Range 38 East, Section 14, WM., NW1/4

Scale 1" = 660'

**Application No. 915473**  
**Permit No. G-15258**

