



RECEIVED

DEC 12 2001

WATER RESOURCES DEPT.
SALEM, OREGON

LEGEND


- Wells
- Streams
- Place of Use
- City Limits

SCALE ADJUSTED
TO BE APPROX.

1" = 1320'


12/17/01

Figure 1
Well location map
Saint Paul, OR

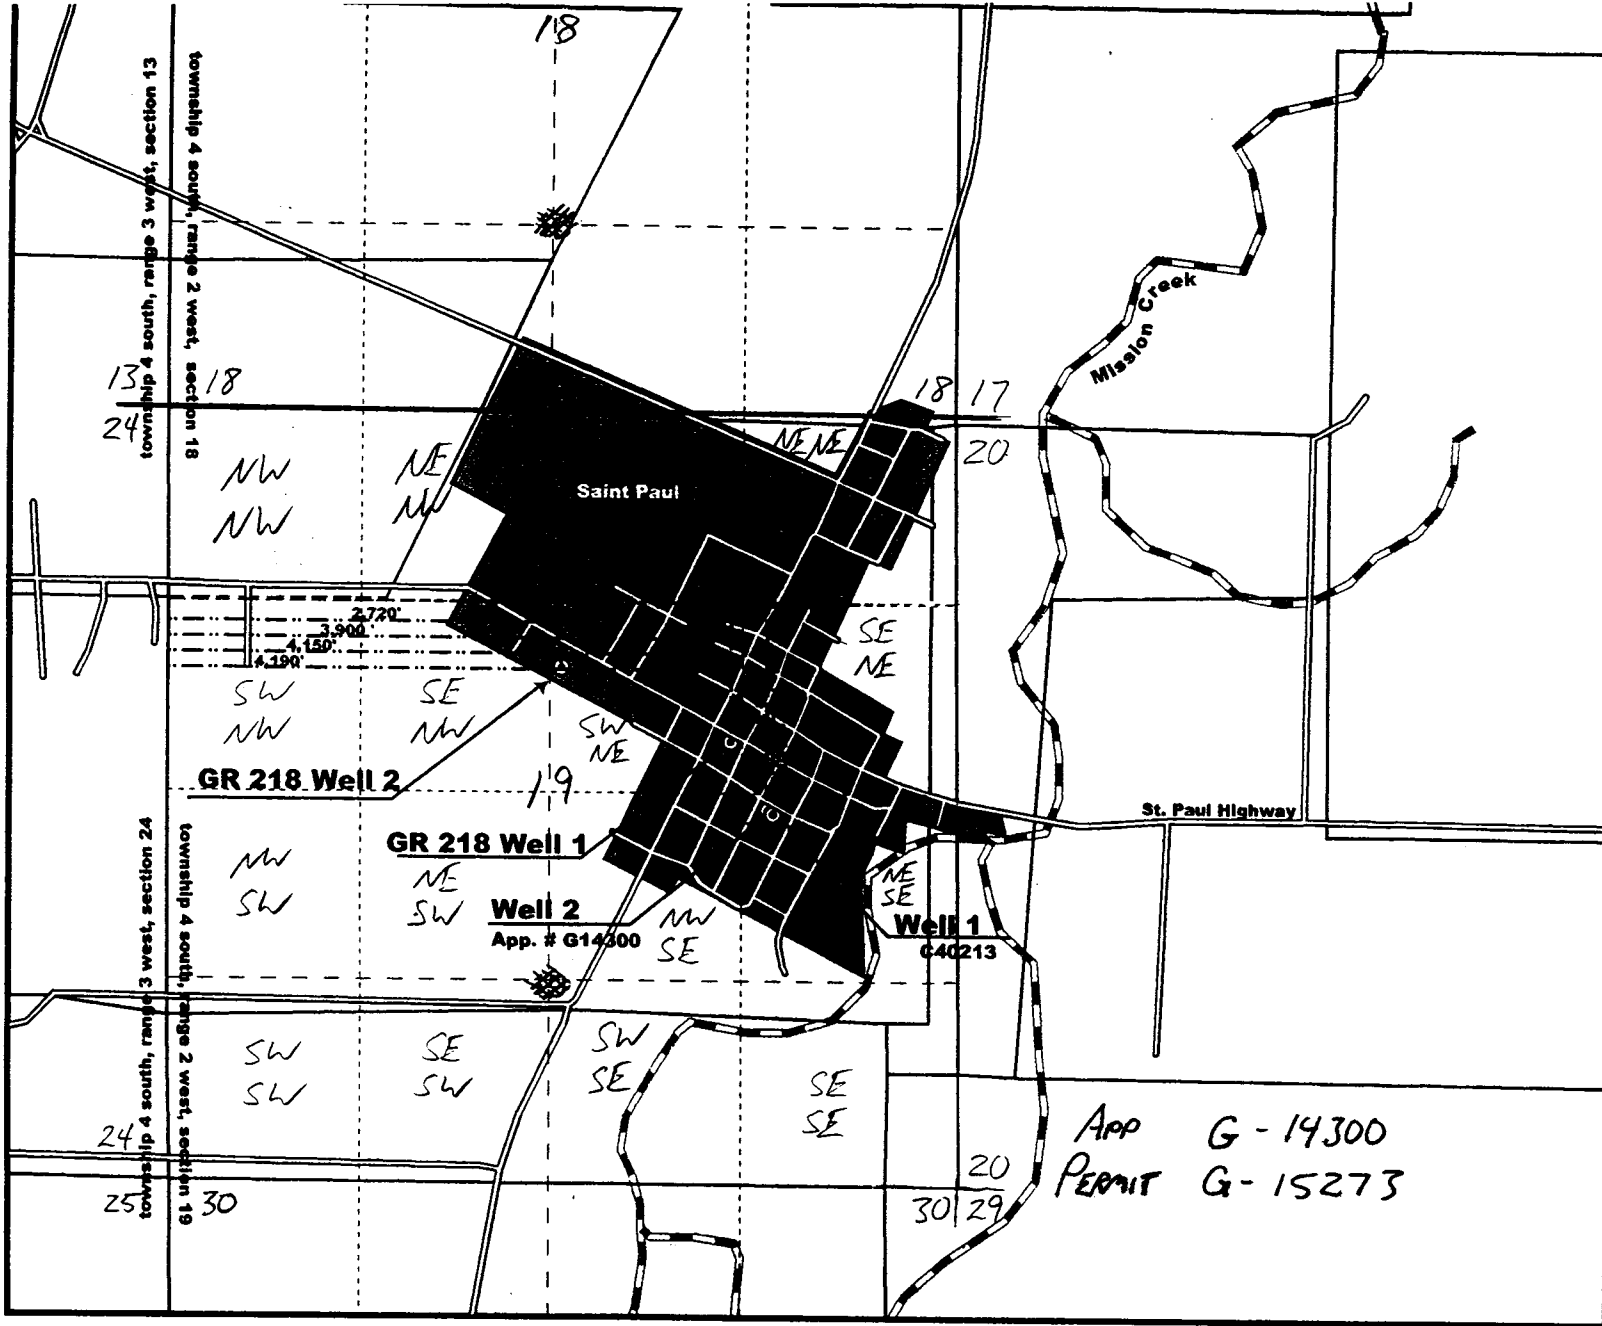

SCALE

1" = 1320'

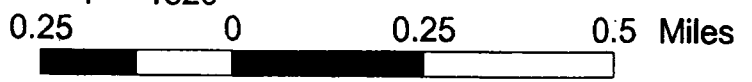

Well 2 (App. # G14300) Location:
4,150 feet East and 1,400 feet South
from the NW corner of Section 19,
Township 4 South, Range 2 West