1"=200'

See Map 6N 35 36B

T.6N, R 35 EWM
Section 36 SW1/4
1" = 200'

1 North

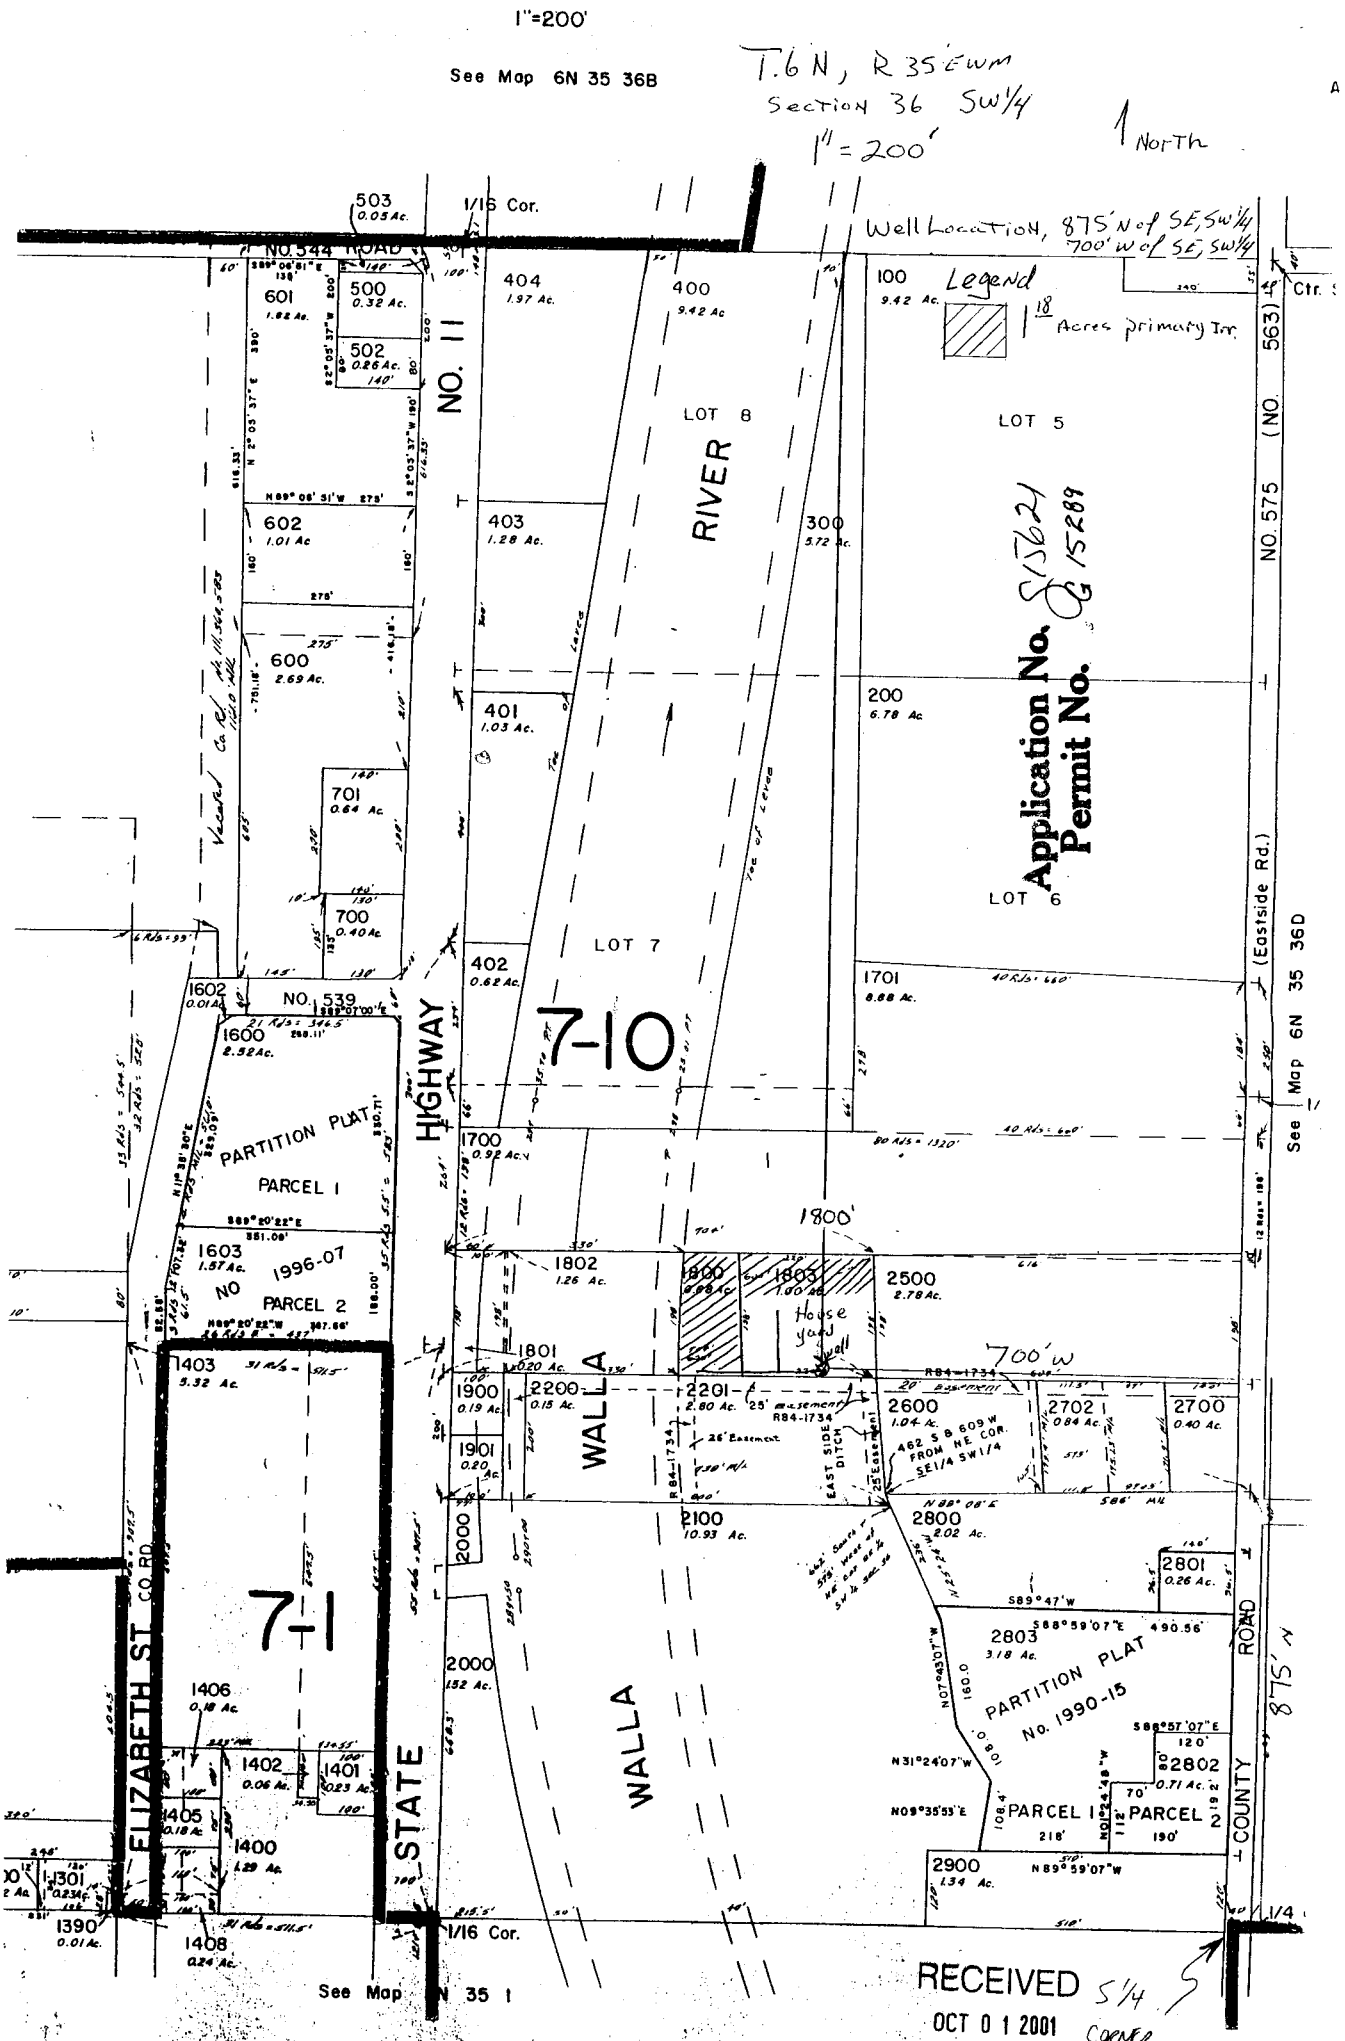

See Map N 35 1

RECEIVED
OCT 0 1 2001
WATER RESOURCES DEPT.
SALEM, OREGON