


TOWNSHIP 11 SOUTH, RANGE 3 WEST, W.M.  
SECTIONS 10, 11, 13, & 14

Application No G-12675  
Permit No. G-15293

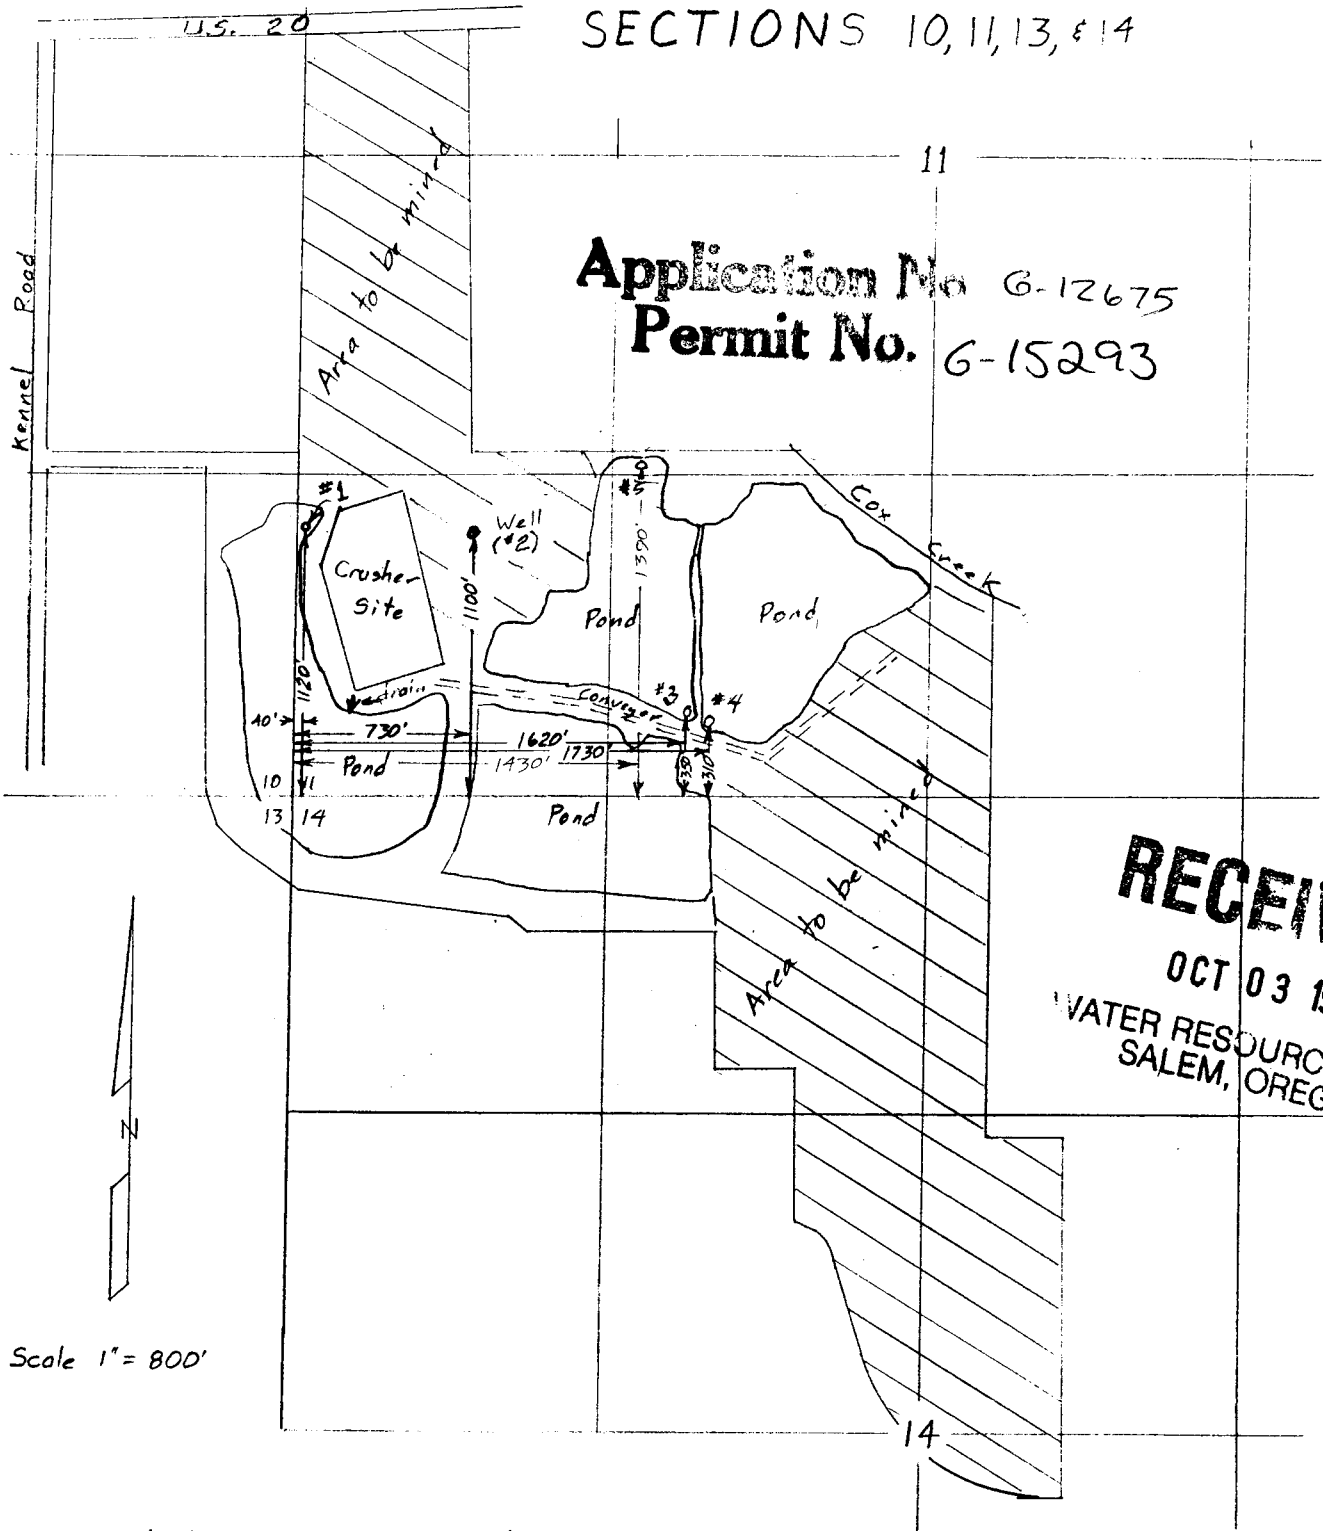

**RECEIVED**

OCT 03 1991

WATER RESOURCES DEPT.  
SALEM, OREGON

Water Right Application Map  
for  
**MORSE BROS., INC**  
( Albany )

Certified Water Right Examiner  
#1  
*Bruce A. Estes*  
Bruce A. Estes  
Nov. 19, 1987  
STATE OF OREGON

This map is for the purpose of locating a water right only and has no intent to provide legal dimensions or the location of property lines.

G-12675