


WORKING COPY

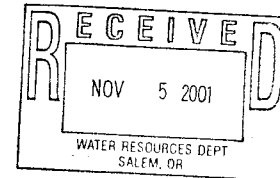

LEGEND

LINE TYPES

TAX LOT BOUNDARY OLD PROPERTY LINE

ROAD RIGHT-OF-WAY VACATED RIGHT-OF-WAY

RAILROAD RAILROAD RIGHT-OF-WAY

STREAM, LAKE, ETC. STREAM, LAKE, ETC.

TAX LOT BOUNDARY NON-BOUNDARY

SURVEYOR BOUNDARY PARTITION PLAT BKT.

TAX COR. BOUNDARY BARRIAGE

SYMBOL TYPES

B.L.C.

CONTROL POINTS

SURVEY MONUMENTS

G.L.C. CORNERS

SECTION 1/4 SEC. 1/4 SEC.

1/4 SEC. 1/4 SEC.

NUMBERS

TAX COR. NO.

000 00 00 0

ACREAGE - ALL ACREAGES EXCLUDE ANY PORTION THAT MAY BE WITHIN THE DEDICATED PUBLIC RIGHT OF WAYS.

TICK MARKS - WHEN A TICK MARK IS INDICATED ON THE EXTENSION OF A LINE, THEN THE DIMENSION CLOSE TO THE TICK MARK GENERALLY THIS IS USED WHEN DIMENSIONS GO OUT TO PUBLIC RIGHT OF WAYS.


ARROWS ARE USED WITH DIMENSIONS IN AREAS OF GREATER COMPLEXITY.

NOTICE: This map was created for Assessor's Office use ONLY.



SCALE 1" = 800'

Plot file created: January 26, 1998

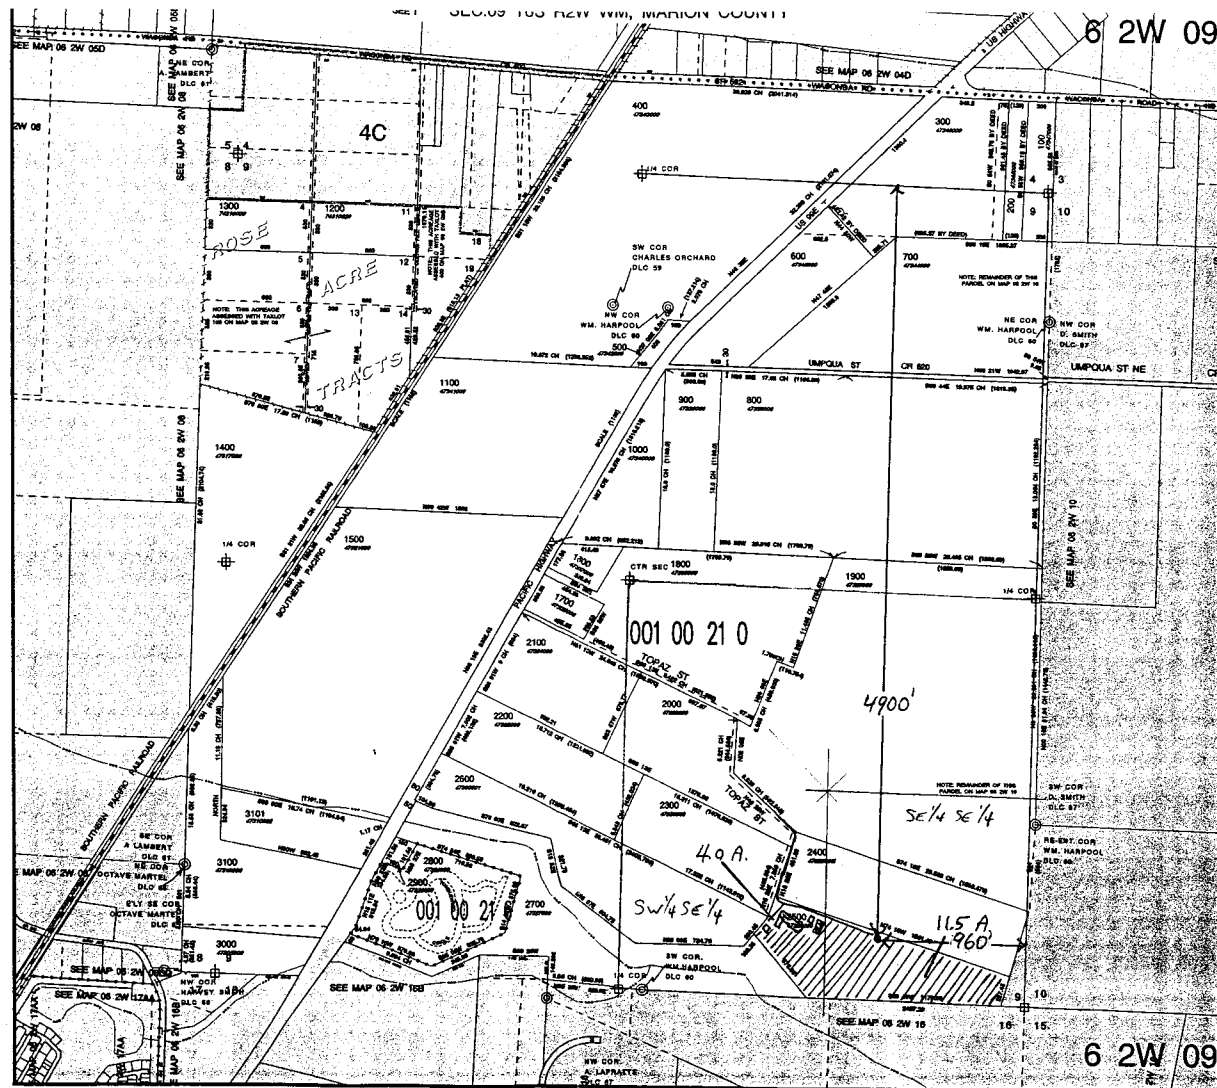

4900 FT. SOUTH &
960 FT. WEST
FROM
COMMON CORNER
SECTIONS 3, 4, 9, 10.

1" = 800 FT.

Application No. G-15647
Permit No. G-15297.