Application No. G-15645
Permit No. G-15317

SECTION 30 T2N R3W W.M.

WASHINGTON COUNTY OREGON

SCALE 1" = 400'

SEE MAP 2N 3 19

2N 3 30

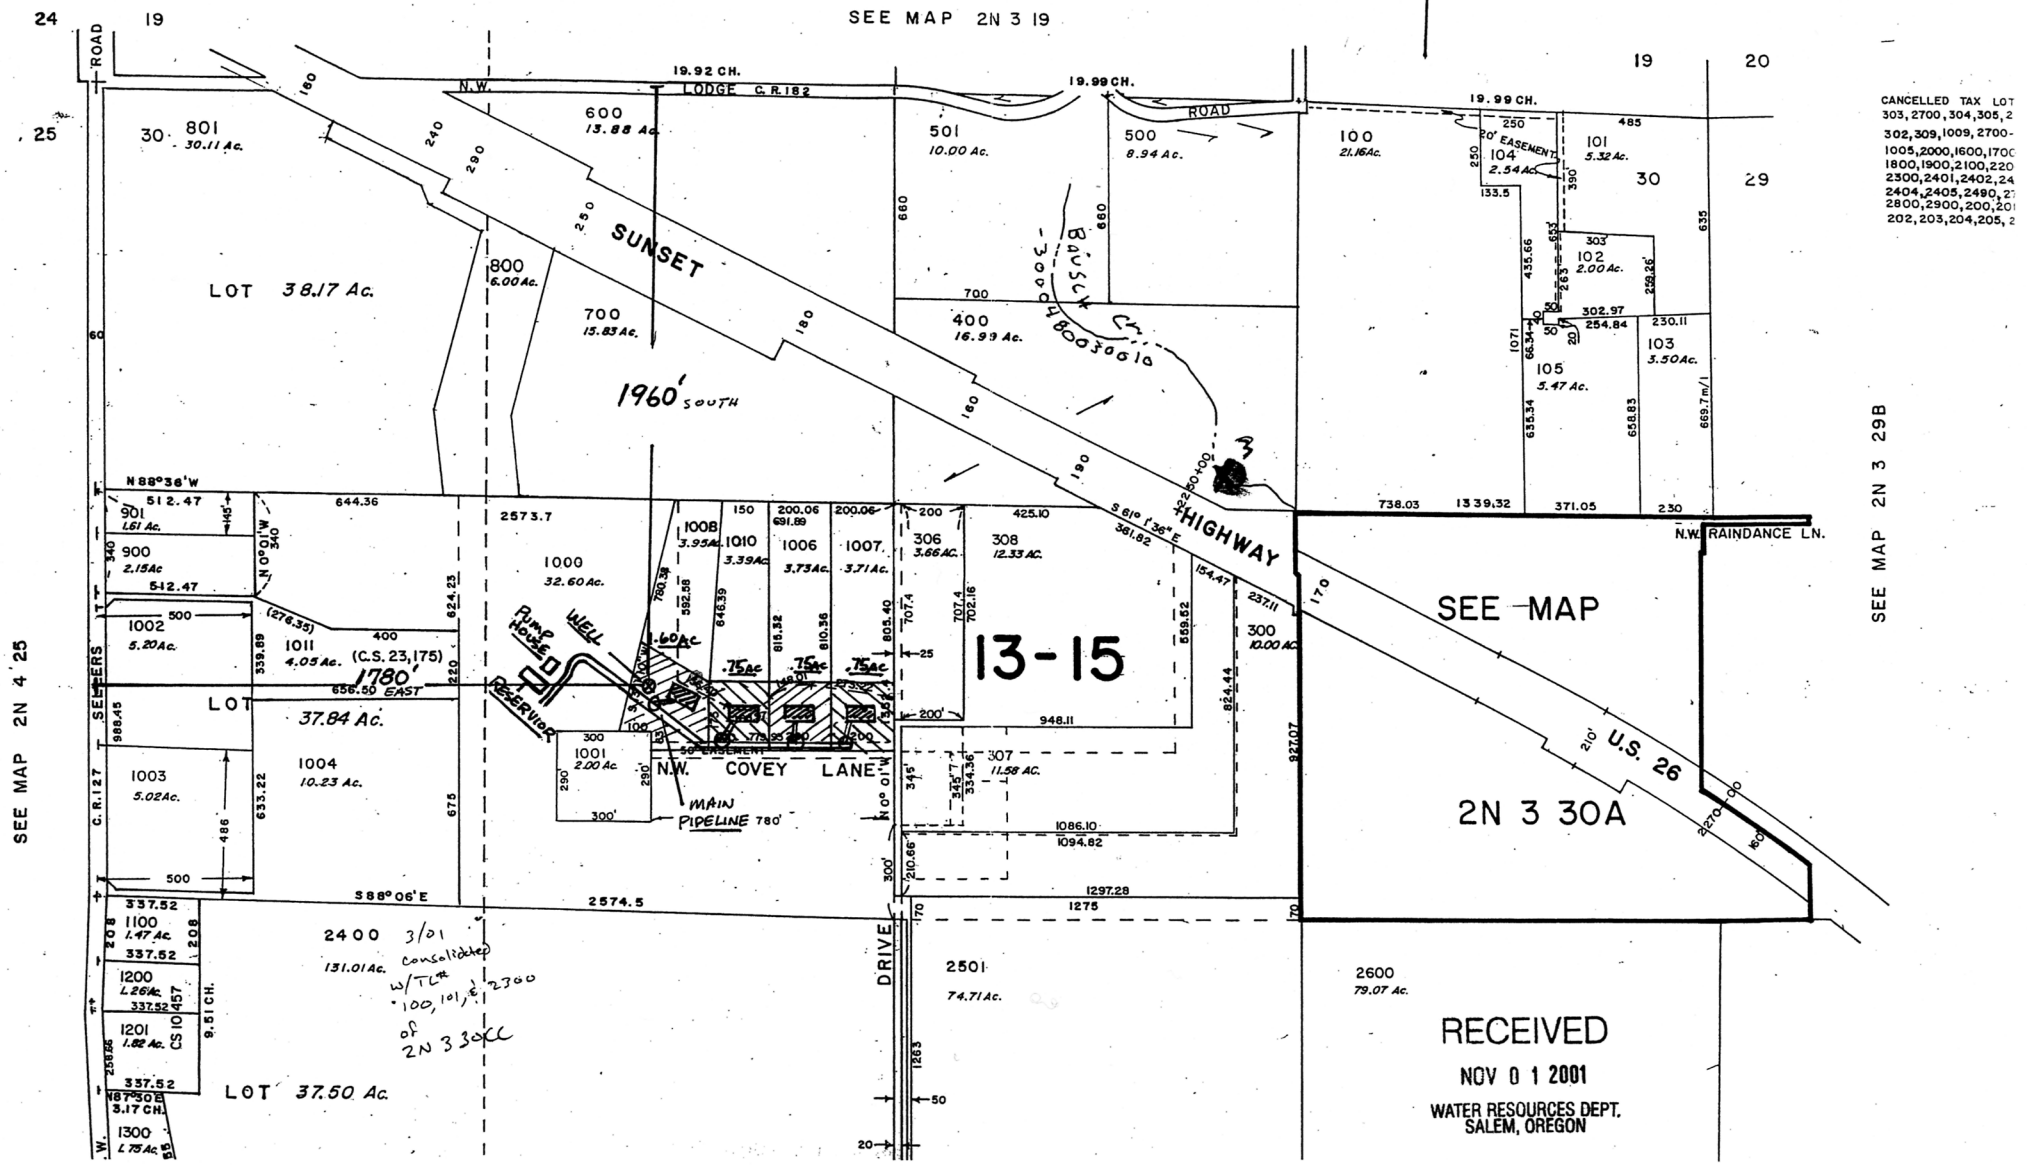

RECEIVED
NOV 0 1 2001
WATER RESOURCES DEPT.
SALEM, OREGON