

Ctr. Sec. + CO. RD.

500  
9.85 Ac.

400  
29.54 Ac.

See Map 4N 28 02C

330'

1198.77'

600  
24.84 Ac.

874.94'

189° 41' 53" W  
100.40'  
104° 24' 54" W  
10.43'

N 89° 53' W

1187.55'

DRAINAGE

1200  
0.38 Ac.

1102  
2.00 AC

HERMISTON

1100  
12.25 AC

405.13'

300 24' 54" E

60'

N 89° 41' 53" E Easement

1/4 Cor. ( CO. RD.)

( E.

3


2 T.4N. R28E.W.11.  
ILLA COUNTY

1"=200'

ee Map 4N 28 02A





SEP 5 2001  
WATER RESOURCES DEPT  
SALEM, OR

Aerial Photo No. NZ-IP-122

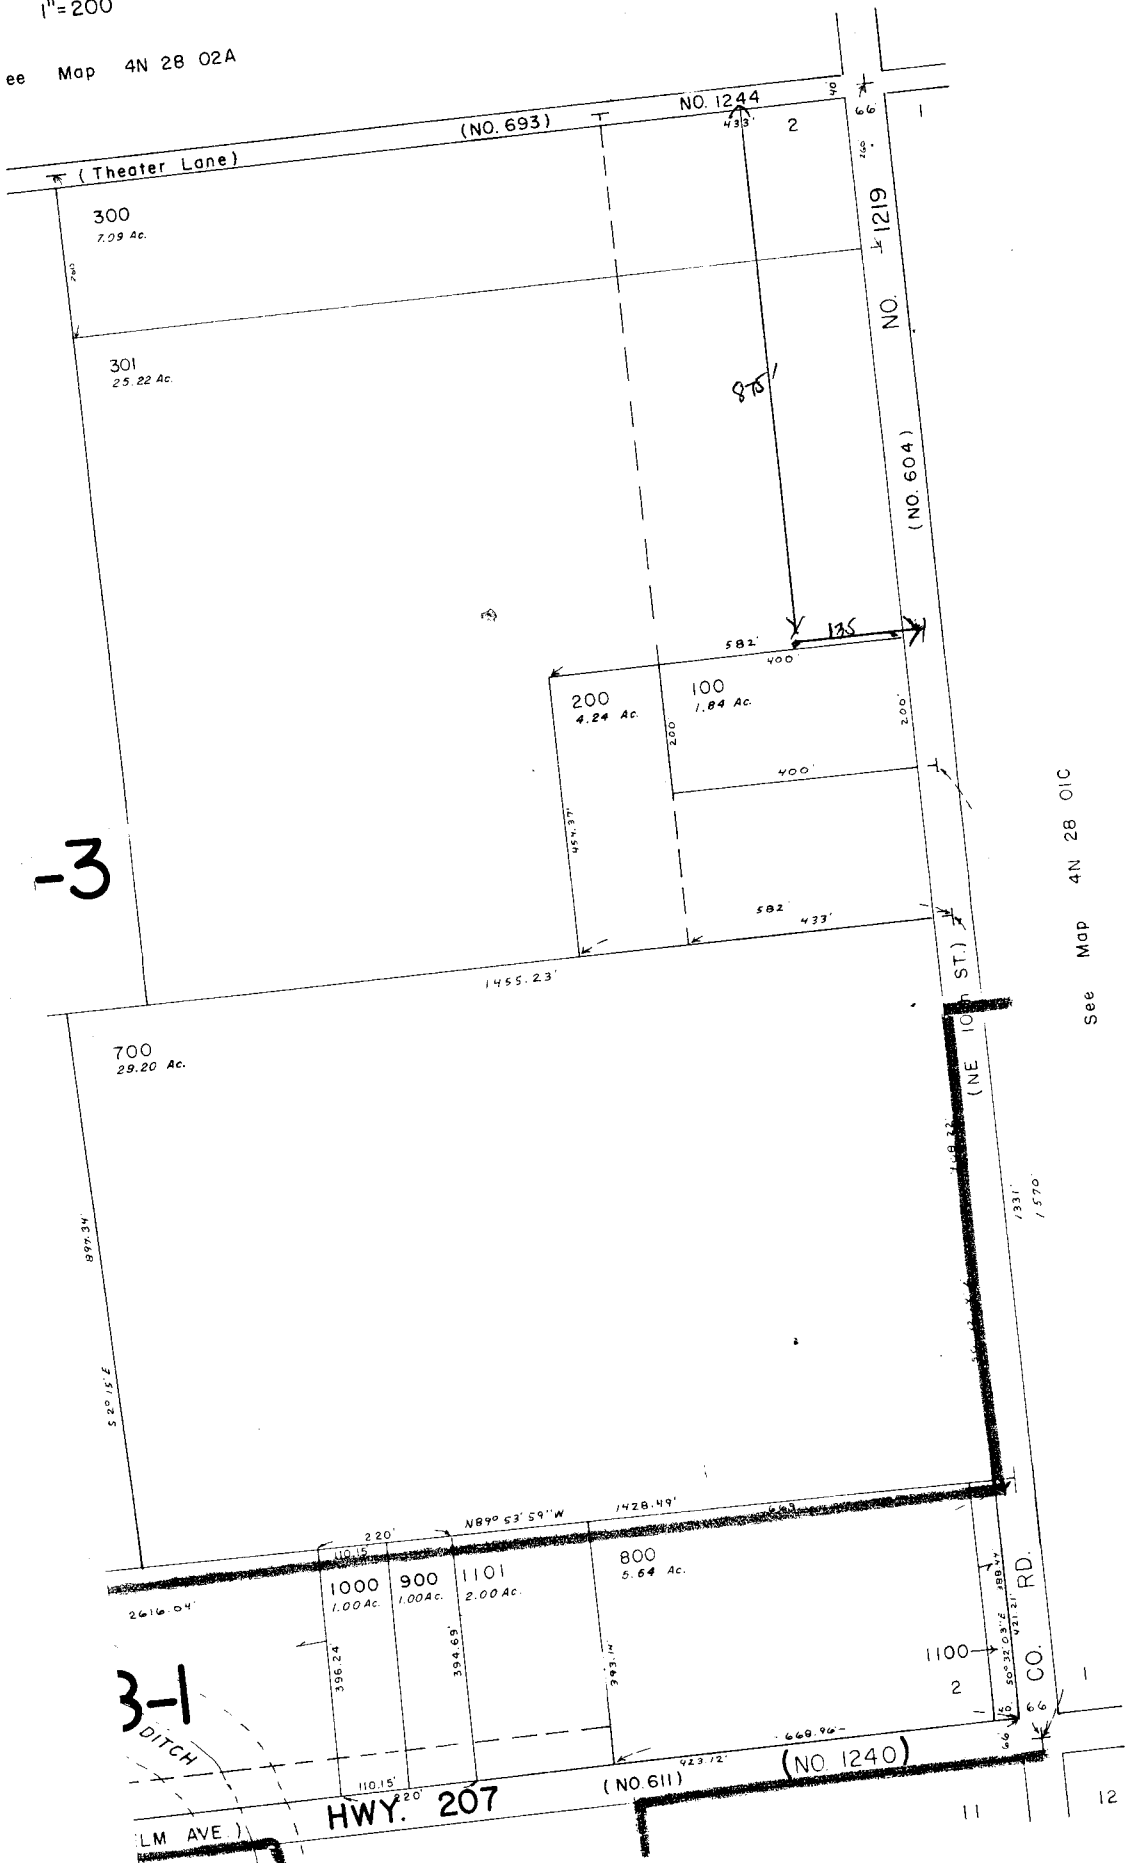

See Map 4N 28 01C

4N 28 02D

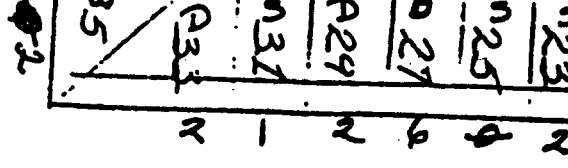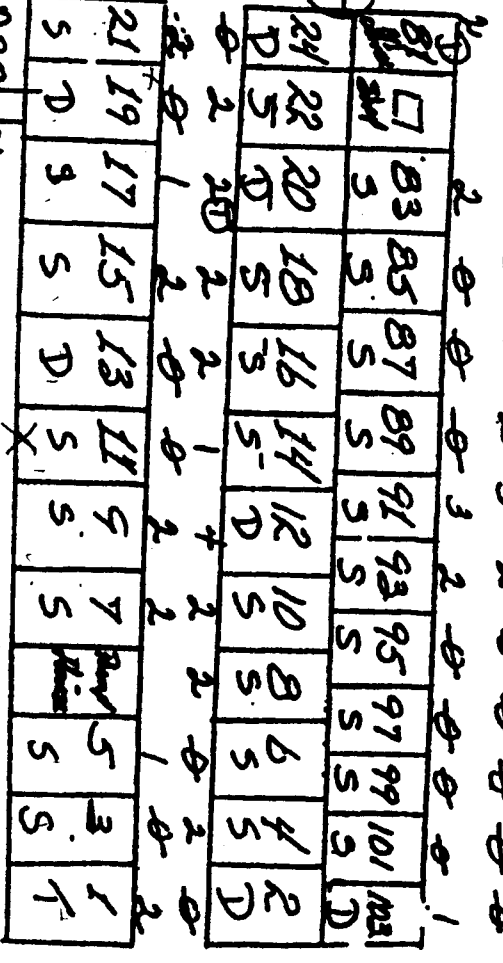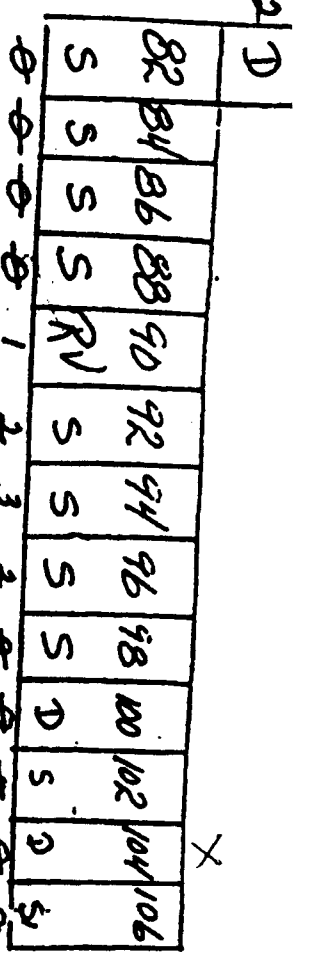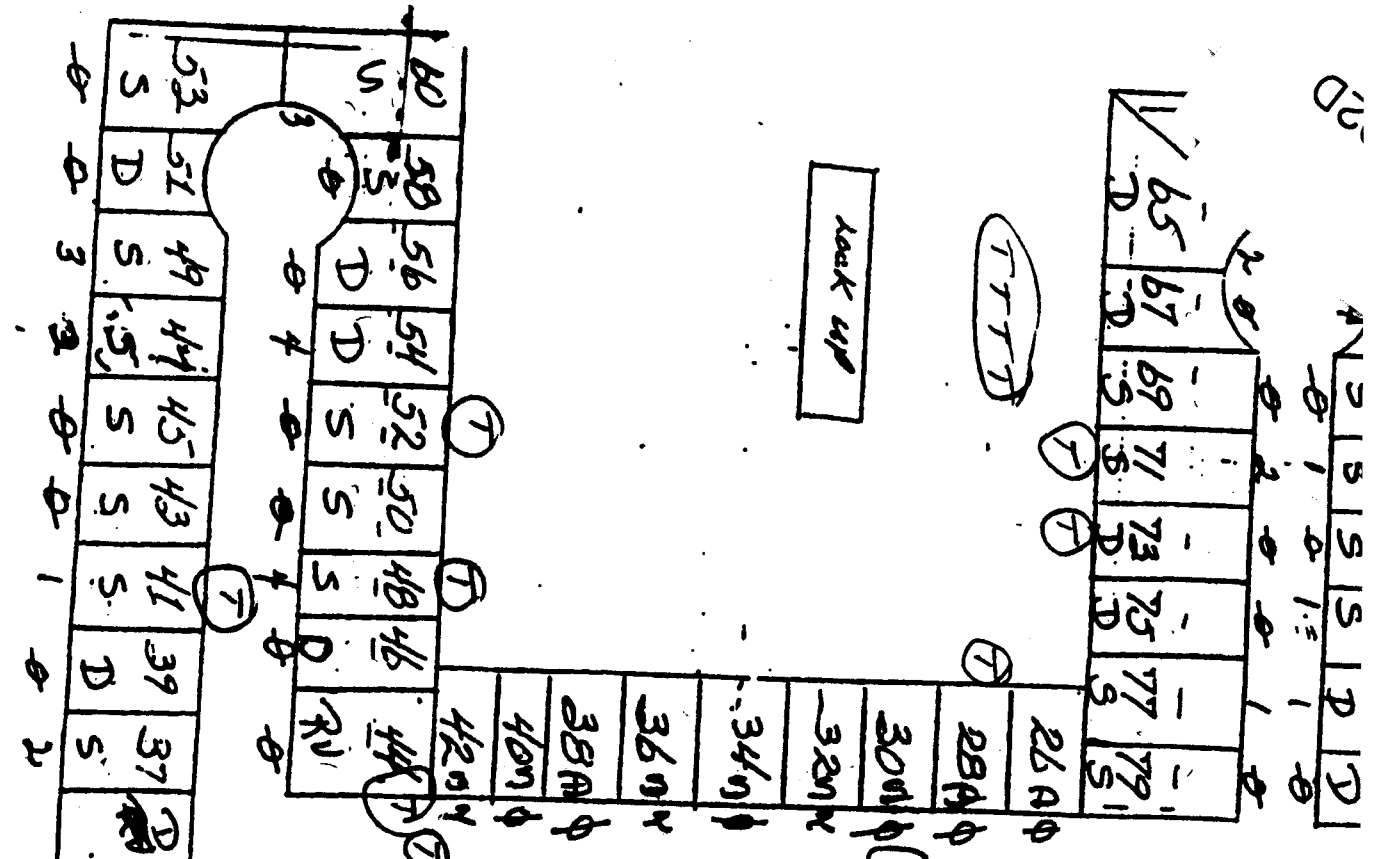

WYSTA PARK MOBILE HOME ESTATES  
1800 N.E. 10th  
HERMISTON, OREGON 97838

