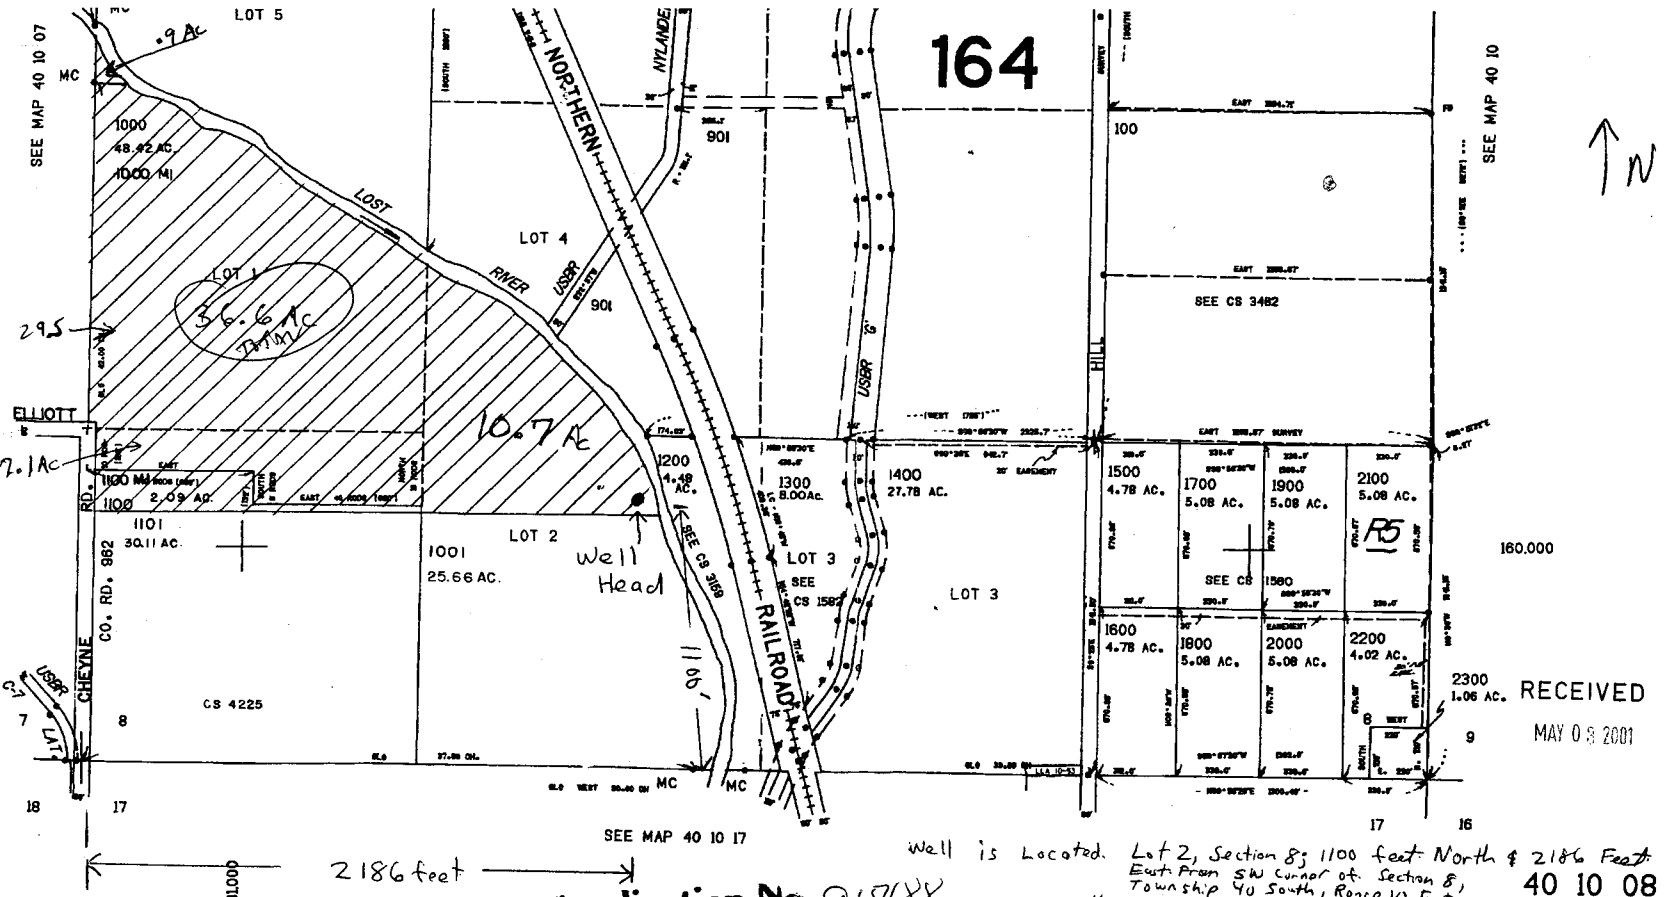


Well is Located. Lot 2, Section 8; 1100 feet North & 2186 Feet East from SW Corner of Section 8, Township 40 South, Range 10 East, W.M.

40 10 08

1" = 500 feet

File # G15360

RECEIVED

MAY 0 8 2001

**Application No.** 915488

**Permit No.** G015320

Tax lot # 4010-00800-01000