ER ADJUDICATION
AIM MAP

1240'S
2300'E
FROM NW COR SEC 8

MATCH TO SHEET 36

40 South, 10 East Section 8

1"=400'

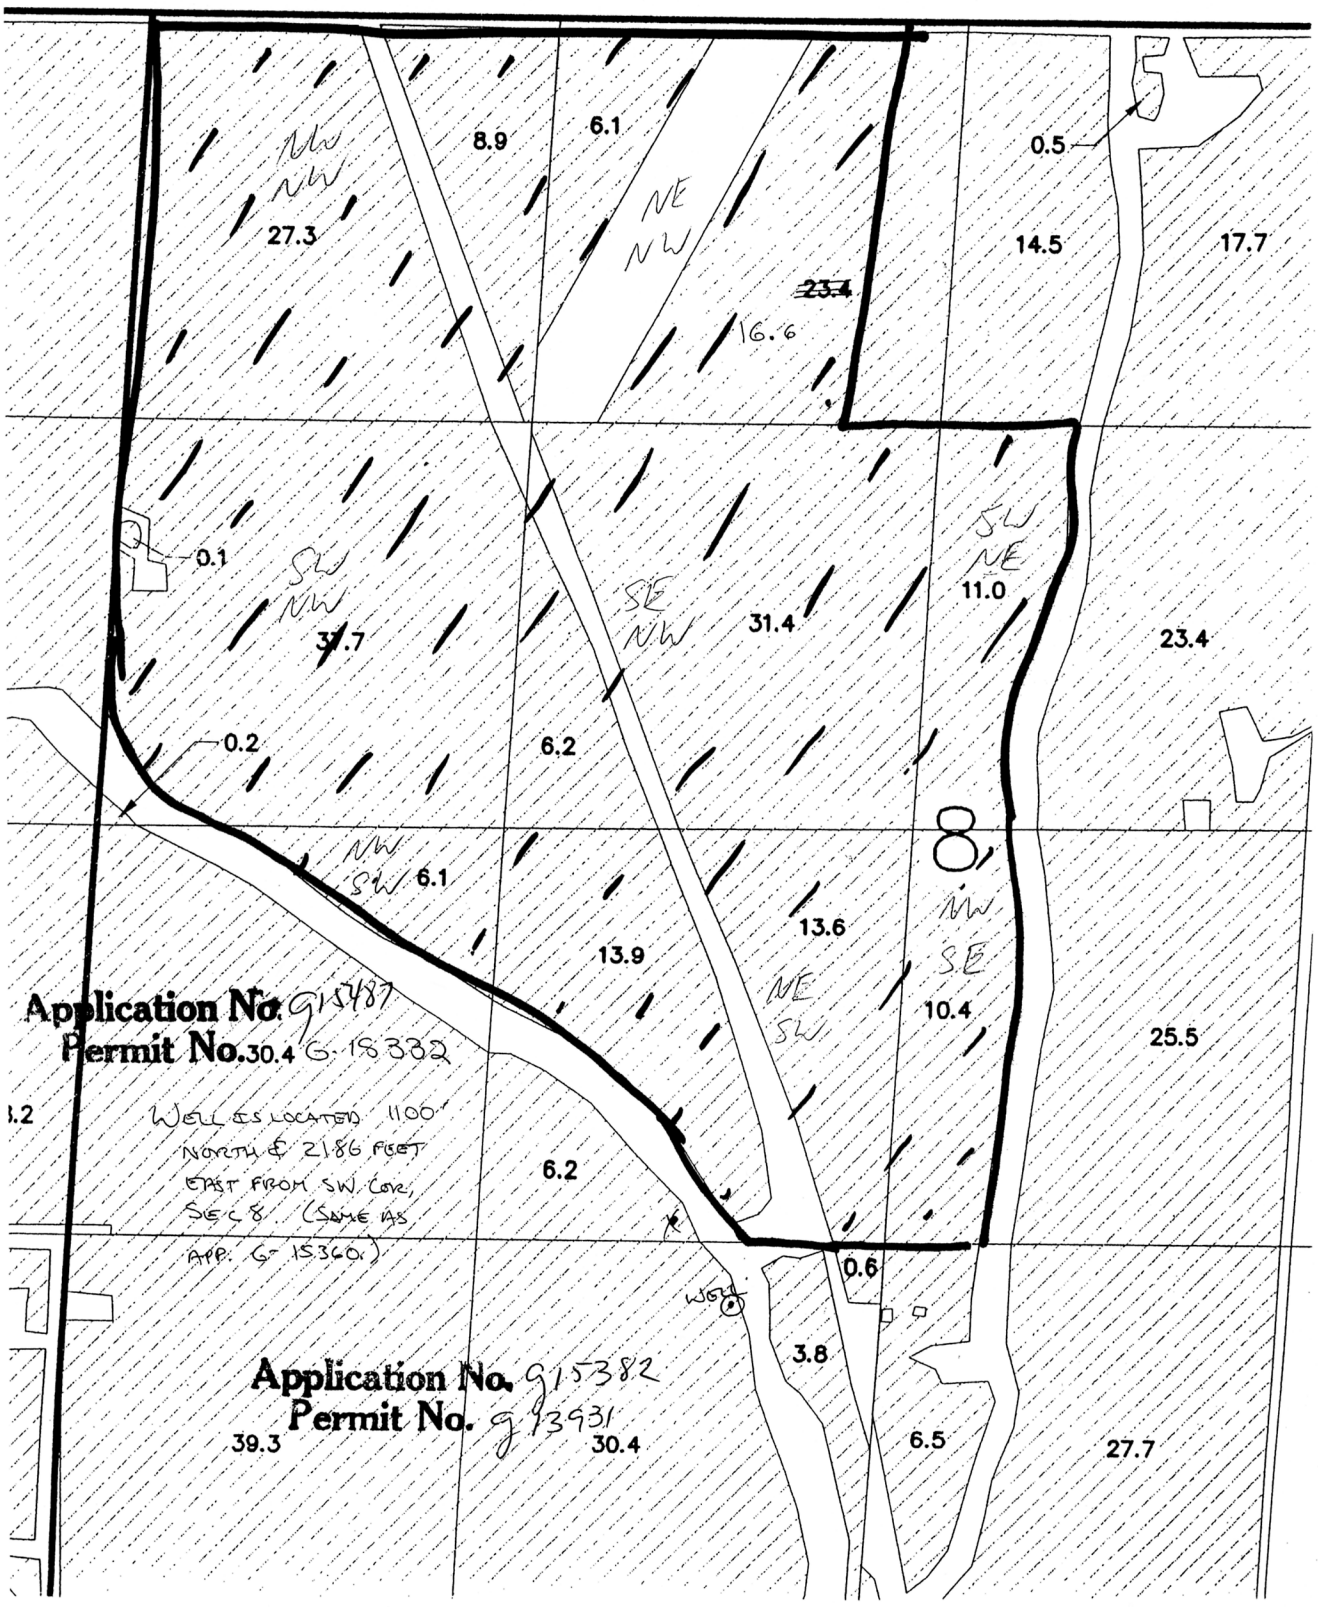

RECEIVED
MAY 03 2001

THIS MAP WAS PREPARED FOR ASSESSMENT PURPOSE ONLY

SECTION 08 T.40S. R.10E. W.M.
KLAMATH COUNTY
1"=400'

40 10 08

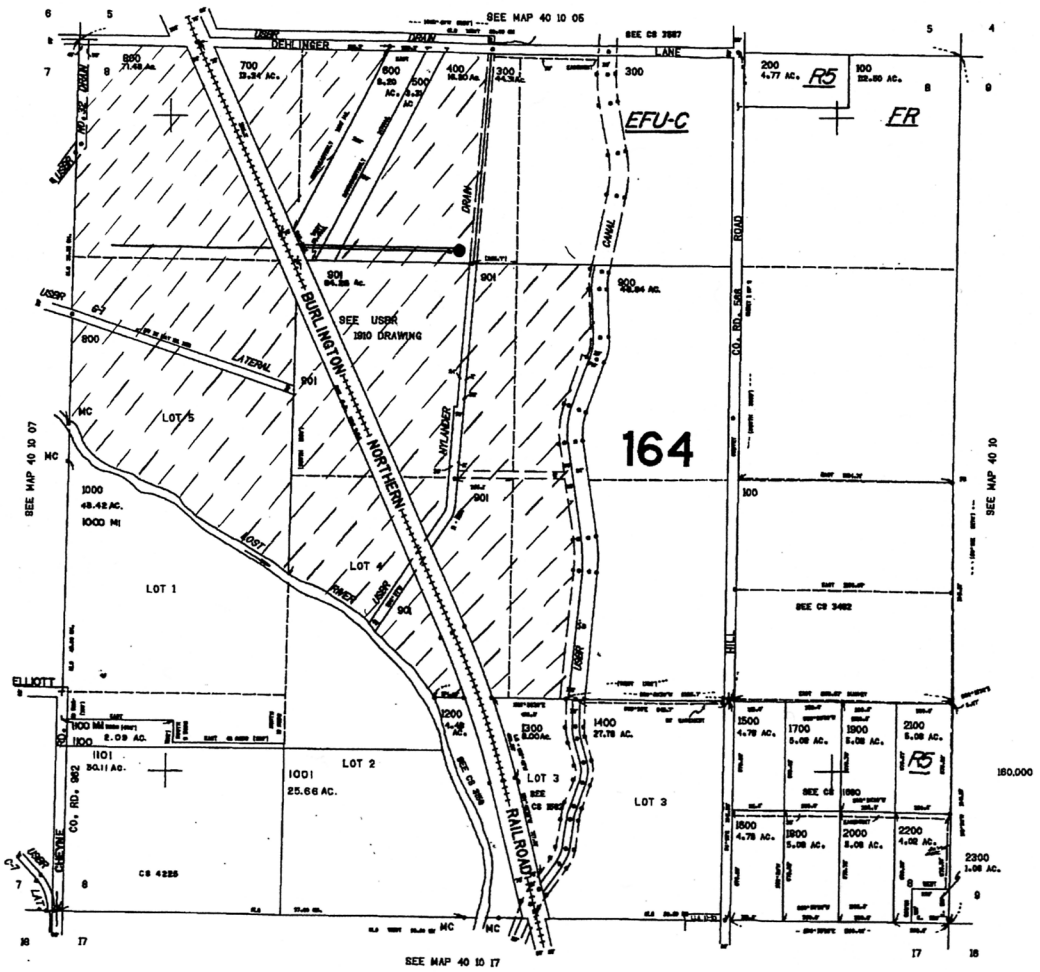

Application No. 51487

PROPOSED PLACE OF USE

PROPOSED

40 10 08