

Application No

G-15564

SECTION 11 T1N R2W W.M.

WASHINGTON COUNTY OREGON


RECEIVED

DEC 07 2001

WATER RESOURCES DEPT.  
SALEM, OREGON

Permit No G-15334

SCALE 1"=400'

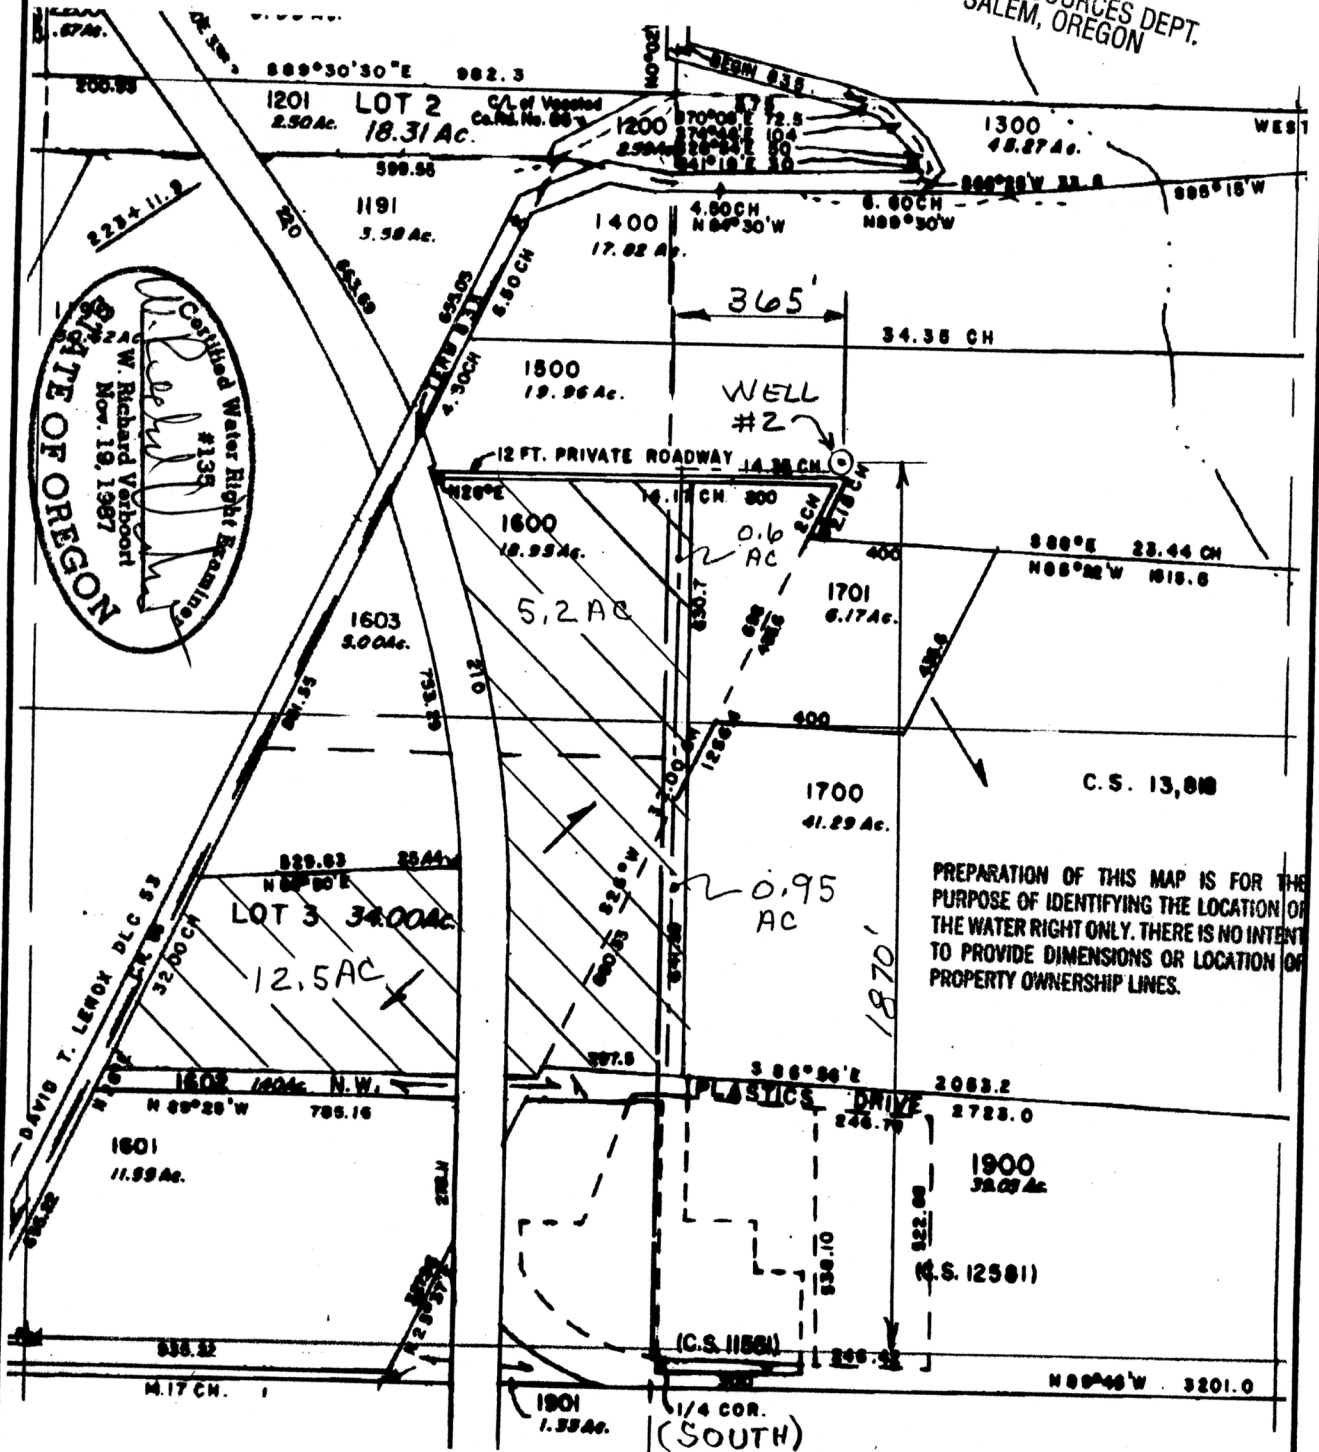

VERBOORT ENGINEERING  
AGRICULTURE-CIVIL-WATER RESOURCES  
HILLSBORO, OREGON

designed	RV	11-01
drawn	RV	11-01
checked		
drawing no.	01-A-10	
sheet no.	1/1	

CASCADIAN NURSERIES, INC  
13495 NW THOMPSON ROAD  
PORTLAND, OR 97229  
ATT: Mr. Alfred Meisner