

NEW


T. 36S, R. 1E, SECTION 6

RECEIVED

JAN 07 2000

WATER RESOURCES DEPT
SALEM, OREGON

Map No. G-15081
Permit No. G-15338

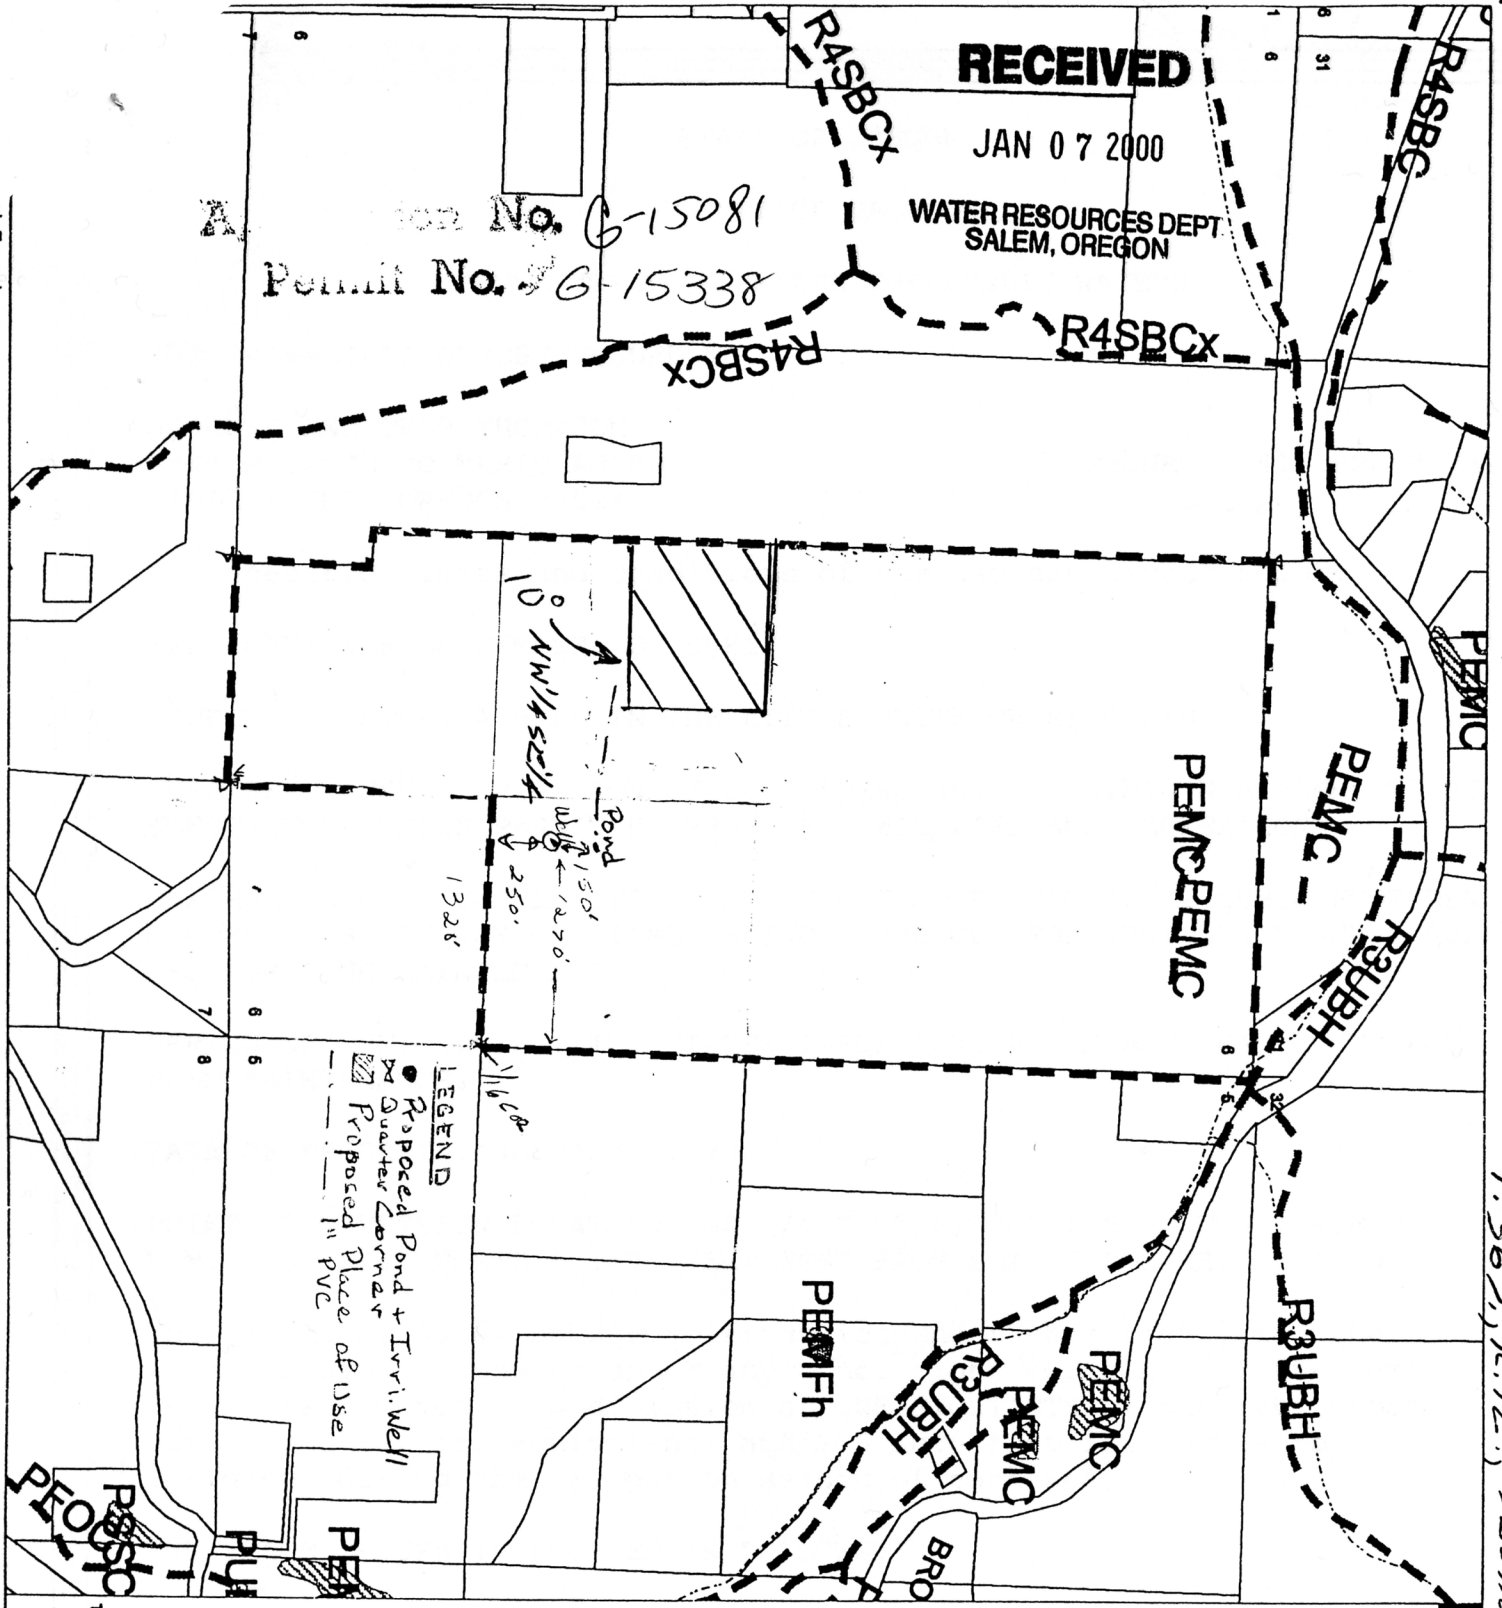

4 office grade paper

S M A R T M A P
JACKSON COUNTY
GEOGRAPHIC INFORMATION SYSTEM

WETLANDS/YES
BROWNSBORO/
EAGLE POINT

APPLICANT:
THOMPSON
36-1E-(06) TL 1700
1999-388-PA

Wetlands
 Wetlands
 Wetlands
 No digital data

0 500 1000 Feet
 1" = 1000 feet



This map is based on a digital database compiled by Jackson County from a variety of sources. Jackson County cannot accept responsibility for errors, omissions or positional accuracy. There are no warranties, expressed or implied.

Plot date: Aug 2, 1999; 14

MAP 2