


T415 R11E

1" = 1320'



RECEIVED
JUN 24 2002
WATER RESOURCES DEPT.
SALEM, OREGON

Approximate
Location of
Wells #1, #2

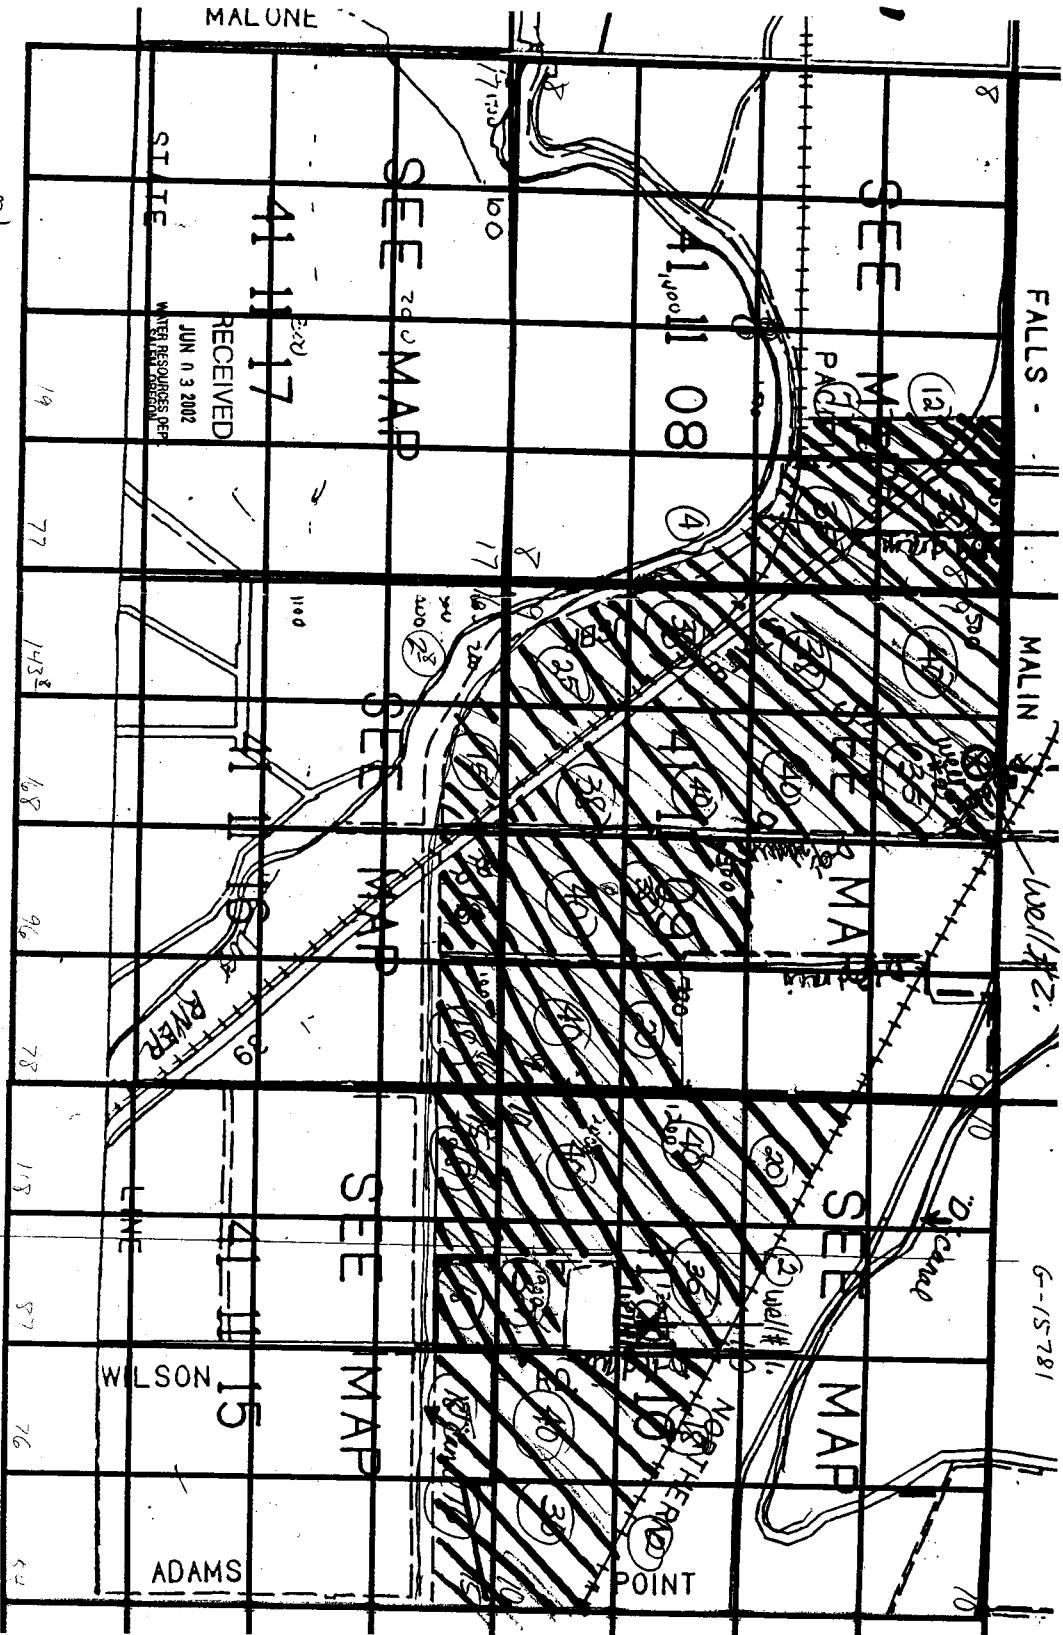

T415 R11E

APP # 6.157801
Permit # 6.15347

(Well 1 - 400 FT N & 500 FT W FROM THE S 1/2 CORNER
WELL 2 - 1050 FT N & 900 FT W FROM THE N 1/2 CORNER)

9/6/84