
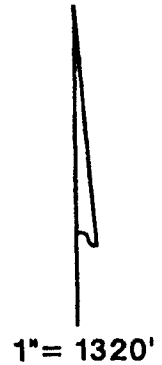


RECEIVED

JUL 25 1997

WATER RESOURCES DEPT.
SALEM, OREGON

T.5S., R.2W., W.M.

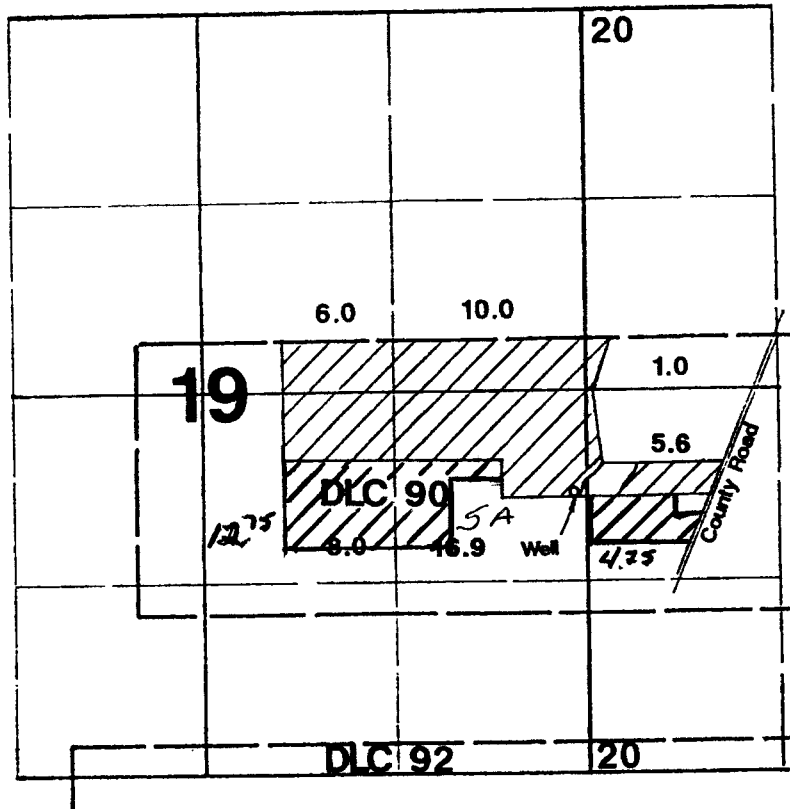

Area Irrigated

Well located 1946'N & 70'W from SE corner Section 19.

Application No. *G-14582*
 Permit No. *G-15378*

Final Proof Survey

Application #: ~~G-13179~~ Permit #: ~~G-13873~~

In Name Of

D.A. Nusom Orchards

Surveyed on July 12, 1996 by JM Schuette

THIS MAP WAS PREPARED FOR THE PURPOSE OF IDENTIFYING THE LOCATION OF A WATER RIGHT ONLY AND IS NOT INTENDED TO PROVIDE LEGAL DIMENSIONS OR LOCATION OF PROPERTY OWNERSHIP LINES

