


Application No. 915745
 Permit No. G-15398

LANE COUNTY
 TOWNSHIP 17S
 RANGE 3W
 SECTION 24

HARVEST 17
 14th ST.

CHURCH

25 24
 SECTION LINES
 COUNTY ROAD
 HAYDEN BRIDGE NO. 667 WAY

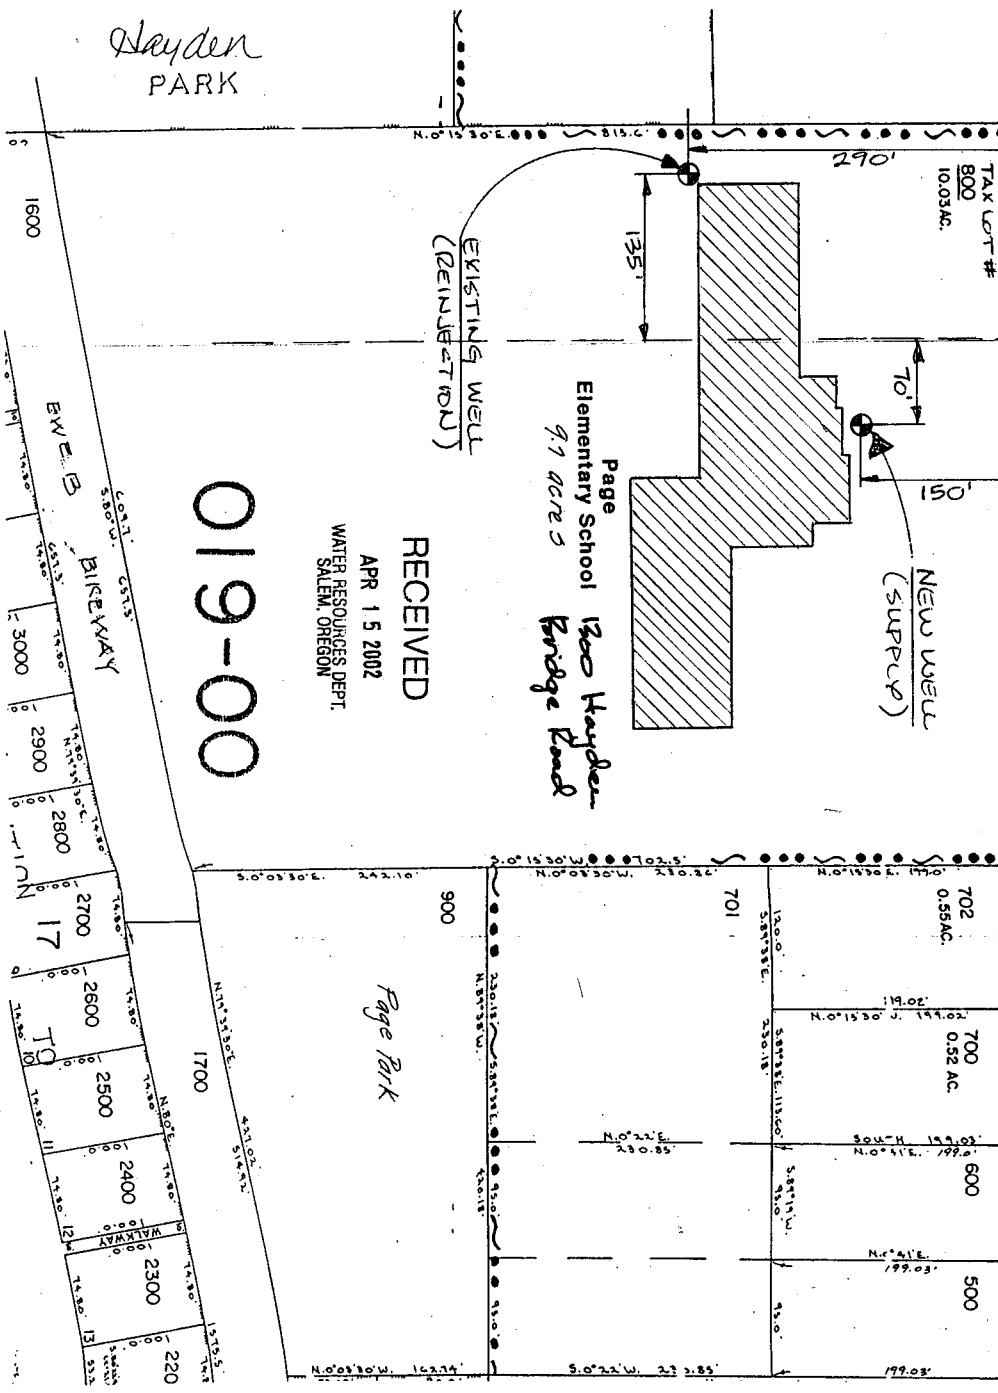

019-00

RECEIVED
 APR 15 2002
 WATER RESOURCES DEPT.
 SALEM, OREGON

Scale: 1"=100'
 N