

RECEIVED

APR 10 2000

WATER RESOURCES DEPT.
SALEM, OREGON


RECEIVED

FEB 20 2001

WATER RESOURCES DEPT.
SALEM, OREGON

NE 1/4 SEC. 23 T.35S., R.6W., W.M.

Application No. G-15326
Permit No. G-15423

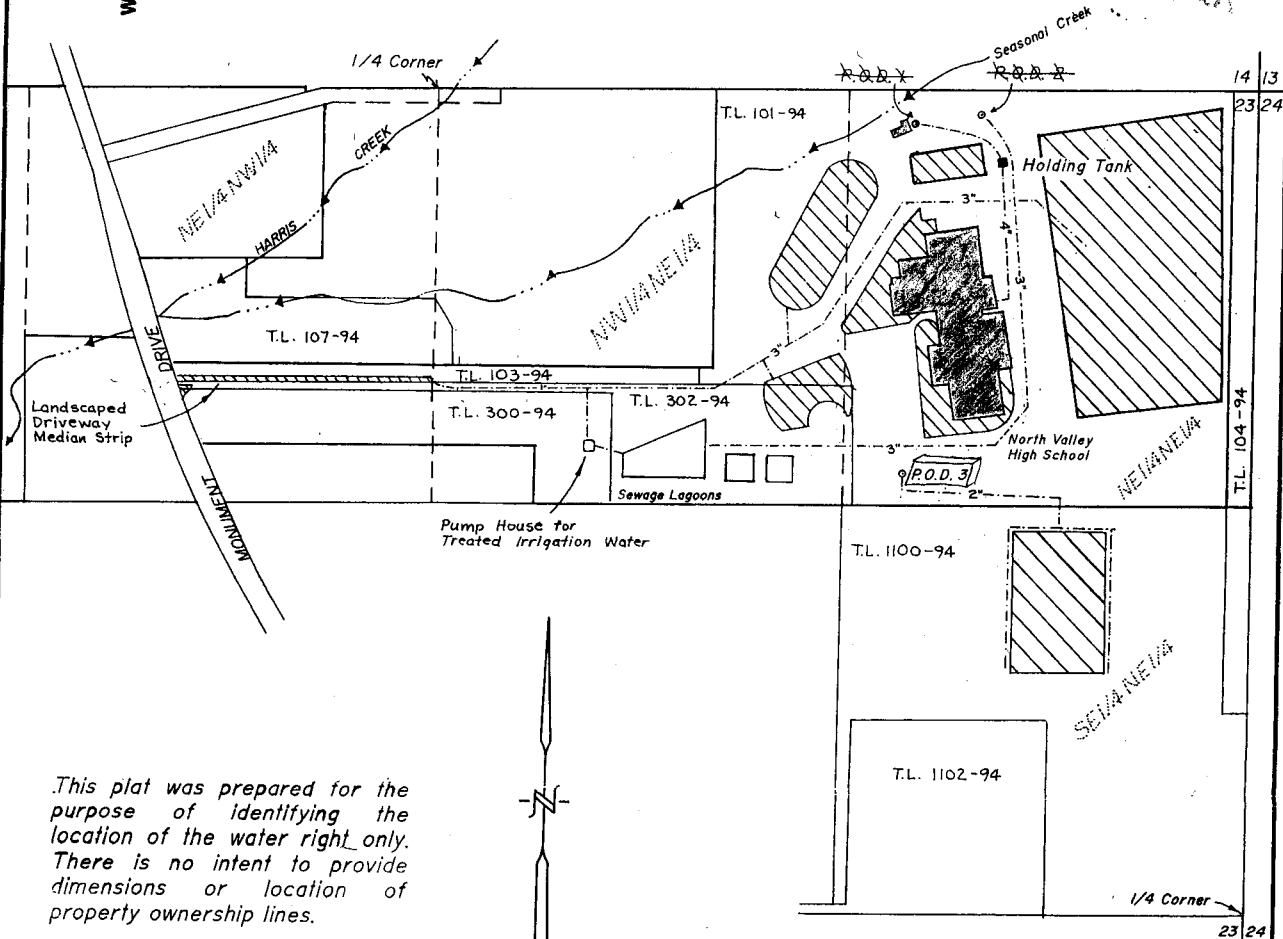


This plat was prepared for the purpose of identifying the location of the water right only. There is no intent to provide dimensions or location of property ownership lines.

NOTE: Location of Buildings are Approximate only. Area of use has been determined by Planimeter from an Aerial Photo dated 6-22-86.

Subject Property: T.L. 101-94, 103-94, 107-94, 300-94, 302-94, 1100-94, 1102-94, Map No. 35-6-23.

Purpose of this application: Appropriate ground water for irrigation.

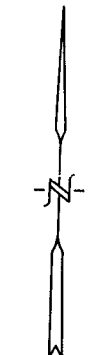

SCALE: 1"=400'

LEGEND:



Proposed Place of Use per this Application:

- 3.0 Acres in NW1/4NE1/4 of Sec. 23
- 16.5 Acres in NE1/4NE1/4 of Sec. 23
- 3.5 Acres in SE1/4NE1/4 of Sec. 23
- 0.3 Acres in NE1/4NW1/4 of Sec. 23

- P.O.D. 1 Existing Well = Point of Diversion 110'S & 1110'W of the NE corner of Section 23
- P.O.D. 2 Existing Well = Point of Diversion 80'S & 900'W of the NE corner of Section 23
- P.O.D. 3 Existing Well = Point of Diversion 1230'S & 1140'W of NE corner of Section 23

--- Approximate location of underground pipeline (Size as shown)

PROJECT NO.
420-95-304

DRAWING NO.
35-1117

DATE
Feb. 7, 2000

SCALE
1" = 400'



PLAT OF WATER RIGHT APPLICATION

LOCATED IN
NE 1/4 Section 23, T. 35S., R. 6W., W.M.
JOSEPHINE COUNTY, OREGON

PREPARED FOR:
THREE RIVERS SCHOOL DISTRICT
8550 NEW HOPE RD.
GRANTS PASS, OR 97527
TEL 862-3111

PREPARED BY:
WICKS ENGINEERING & SURVEYING
311 N.E. "D" Street
Grants Pass, OR 97526
Tel. 479-3436