

SECTION PLAT

Section 7 & 12 & 1 Township 27^S Range 33 & 34

County of HARNEY State of OR


NORTH

RECEIVED

SEP 13 1996

WATER RESOURCES DEPT.
SALEM, OREGON

R-33-E
R-34-E

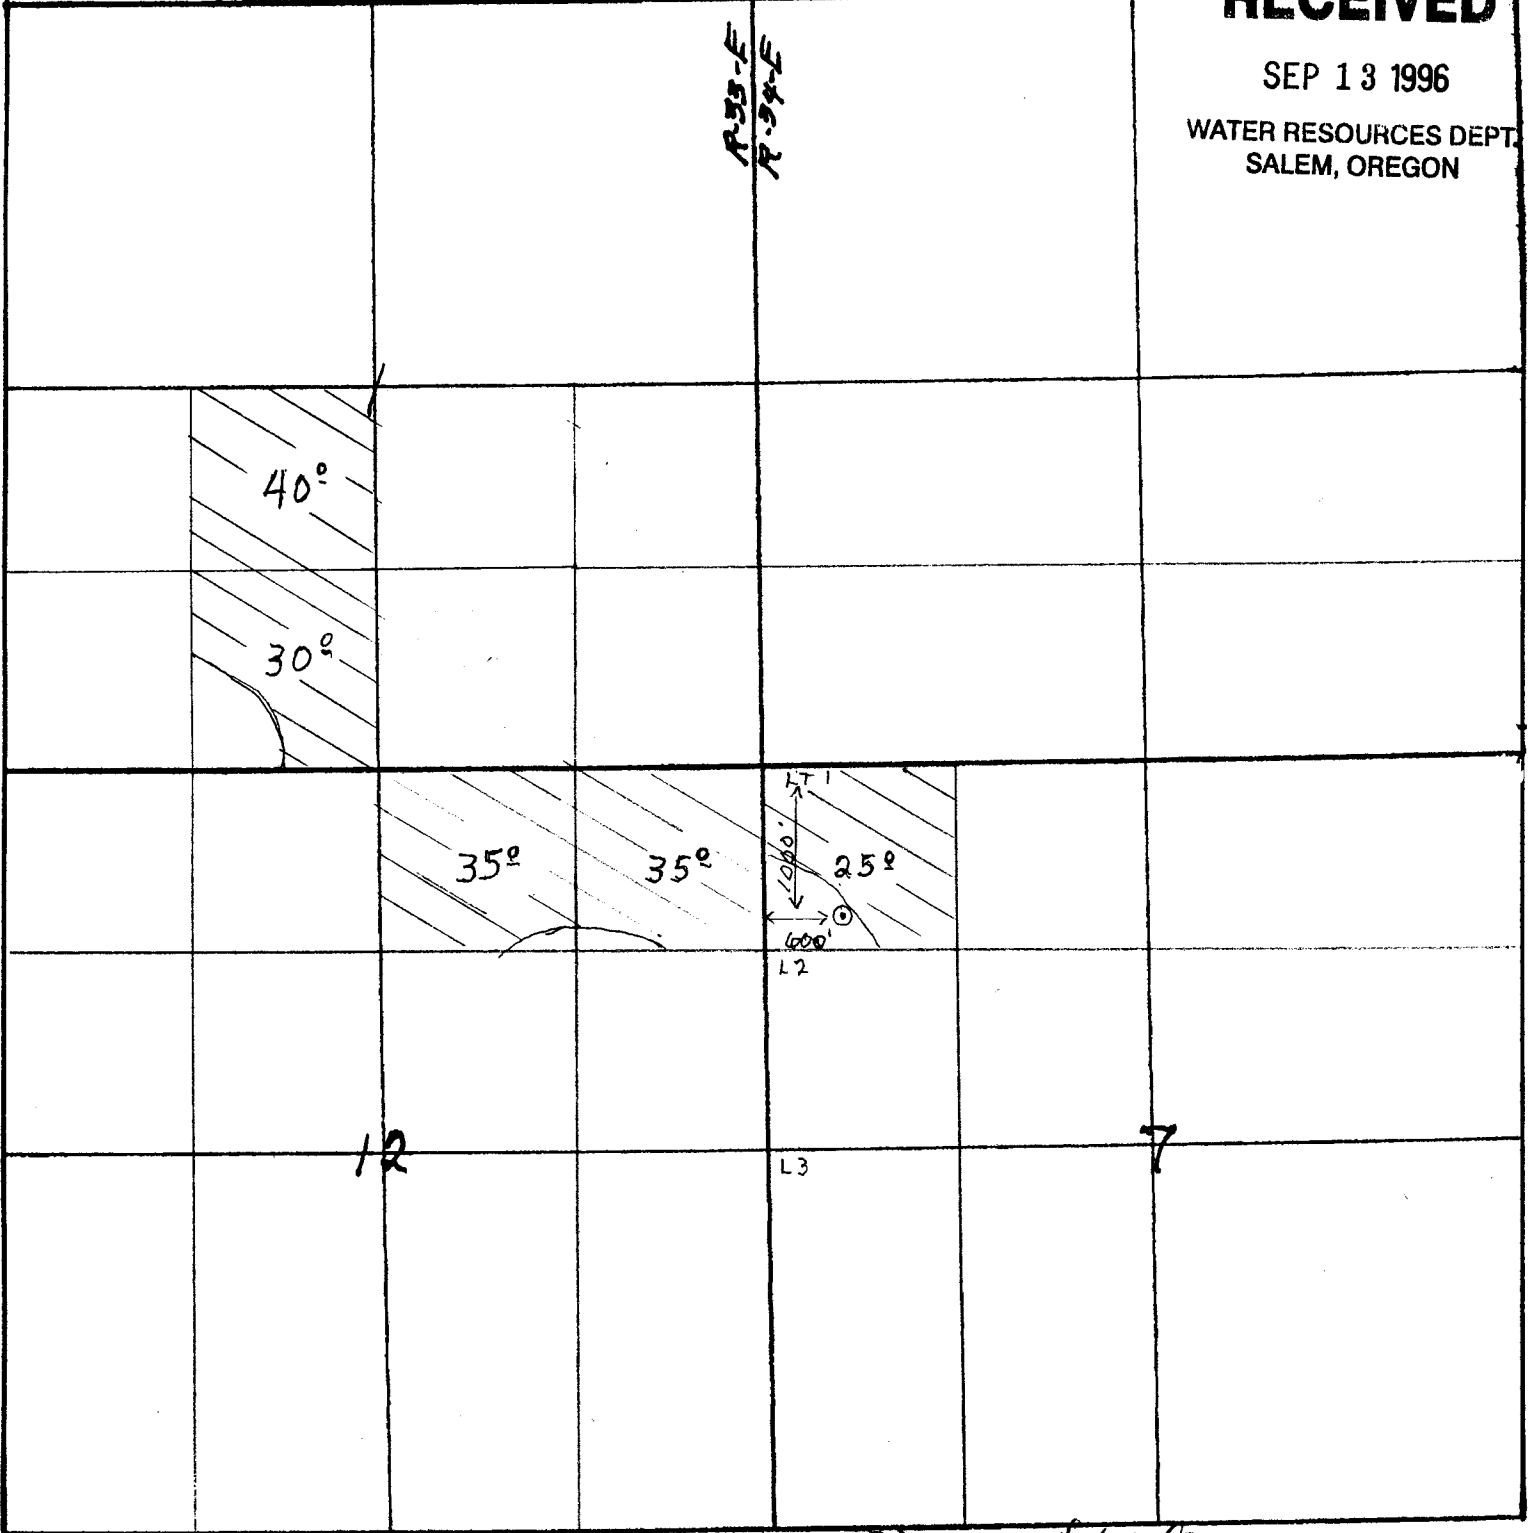

Application No. C-14377

Permit No. C-15432

Remarks scale - 8" = 1 mile - 660' -