



MAP TO ACCOMPANY APPLICATION
IN THE NAME OF
D. WELLS NURSERY

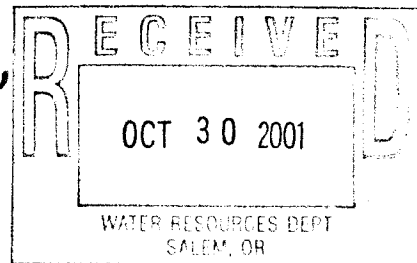

T.4S., R.2W., W.M.
Section 36

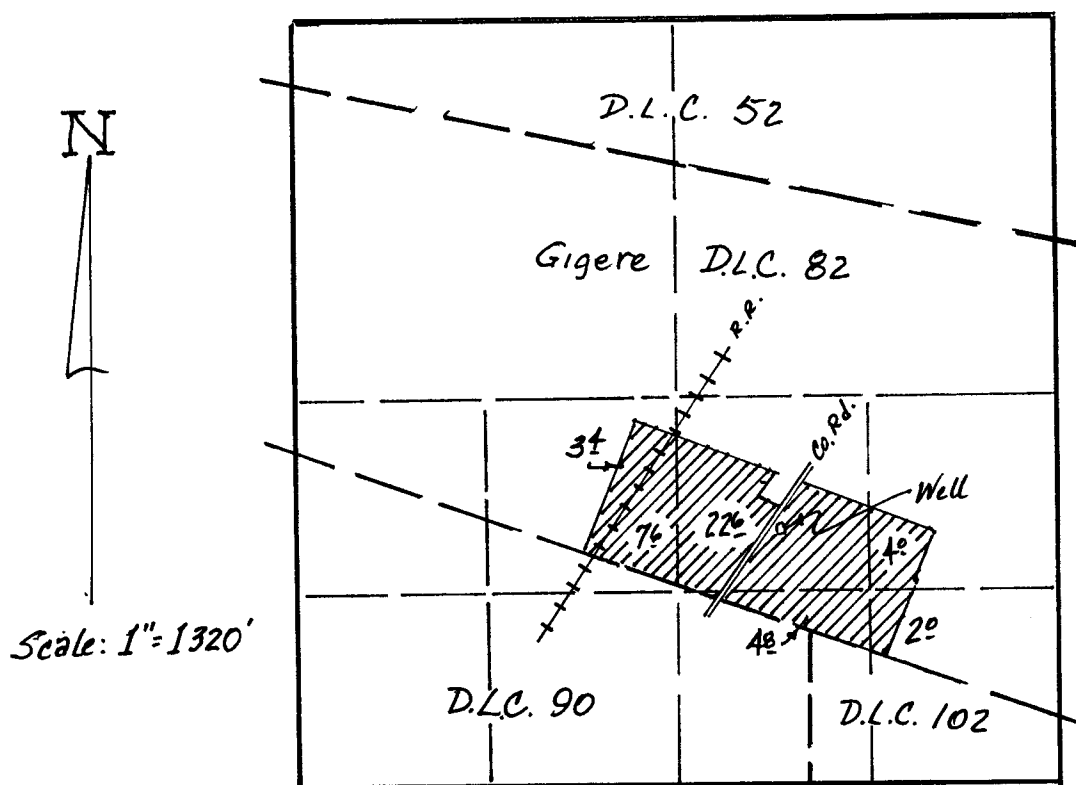

Well location: 700' N. & 190' W. from the
NE Cor. D.L.C. 90.

Application No. G-15644
Permit No. ~~G-15358~~
G-15454