

SE & SW of SE 1/4 and SE of SW SEC. 32, T4S, R1W WM
NE & NW of NE 1/4 and NE & NW of NW 1/4 SEC. 5, T5S, R1W WM
SE of NW 1/4 SEC. 5, T5S, R1W WM
MARION COUNTY, OREGON

THIS PERMIT APPLICATION
THE NELSON FAMILY TRUST
LOCATED IN T4 & 5S, R1W of WM
JAY NELSON dba JAY NELSON, LLC
PROPERTY ADDRESS:
TAX LOTS 1400, 1600 & 1800
BOONE'S FERRY RD
WOODBURN, OR 97071

SECTION 32


SE of SE = 15.8 AC IRRIG.
SW of SE = 25.4 AC IRRIG.
~~SE~~ of SW = **5.5** AC IRRIG
TOTAL = **46.7** AC IRRIG.

SECTION 5

NE of NE = 7.5 AC IRRIG.
NW of NE = 27.8 AC IRRIG.
NE of NW = 39.0 AC IRRIG.
NW of NW = 7.2 AC IRRIG.
SE of NW = 3.5 AC IRRIG.
TOTAL = 85.0 AC IRRIG.
TOTAL = **131.7** AC IRRIG.

APPL. FOR = 718 GPM or
APPL. FOR = 1.6 CFS
MAXIMUM RATE = 1400 GPM)


WELL #1
IS SOURCE OF APPROPRIATION
APPLICATION G-9437
PERMIT G-8669
CERTIFICATE #60725
22.0AC, 0.28CFS, 126GPM

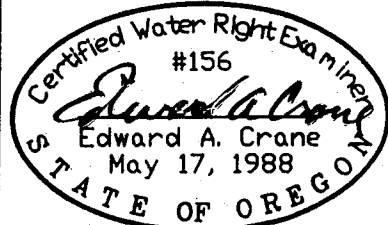

Renewal 12/31/2003
Signed **5.15.2002**

SURVEYED APRIL 24, 2002
BY EDWARD A. CRANE, CWRE

LA\WP_PROJ\365-003\36500301.DWG 5/08/2002 EAC

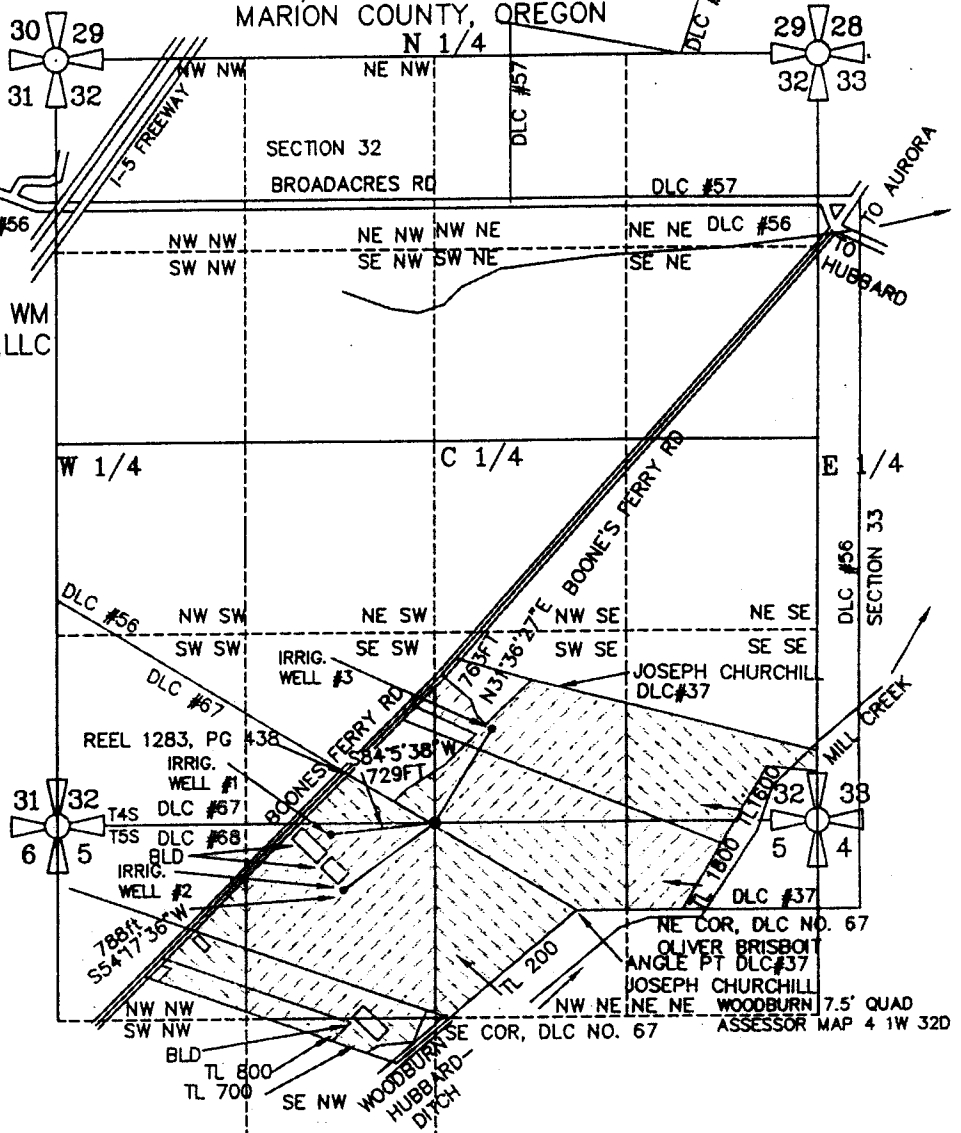

IRRIG. WELL #1 IS LOCATED 460 FEET SOUTH AND 640 FEET WEST
OF THE NORTH 1/4 CORNER OF SECTION 5, T5S, R1W WM, MARION CO.
IRRIG. WELL #2 IS LOCATED 75 FEET SOUTH AND 725 FEET WEST
OF THE NORTH 1/4 CORNER OF SECTION 5, T5S, R1W WM, MARION CO.
IRRIG. WELL #3 IS LOCATED 650 FEET NORTH AND 400 FEET EAST OF
THE SOUTH 1/4 CORNER OF SECTION 32, T4S, R1W WM, MARION CO.

PREPARATION OF THIS MAP WAS FOR THE PURPOSE
OF IDENTIFYING THE LOCATION OF WATER RIGHTS
ONLY AND HAS NO INTENT TO PROVIDE DIMENSIONS
OR LOCATION OF PROPERTY OWNERSHIP LINES.

APPLICATION FOR A
GROUNDWATER PERMIT G-15771


PREPARED BY EDWARD A. CRANE, CWRE

DATE

MAY 2002

PROJECT NO.

365-003

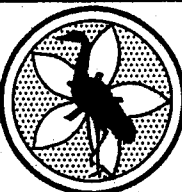

CRANE & MERSETH
Engineering/Surveying
SUITE 'D'
6566 SE LAKE ROAD
MILWAUKIE, OREGON 97222
BUS: (503) 654-2005
FAX: (503) 654-2575

APPLICATION FOR PERMIT NUMBER G-

PERMIT NUMBER G- IN THE NAME OF:

JAY G. NELSON dba JAY G. NELSON, LLC
17280 BOONE'S FERRY RD, NE (TEL: 981-7494)
WOODBURN, OR 97071 (FAX: 503-981-7224)

SHEET

1/2