


T 22 S,  
T 23 S, R 33 E, WM

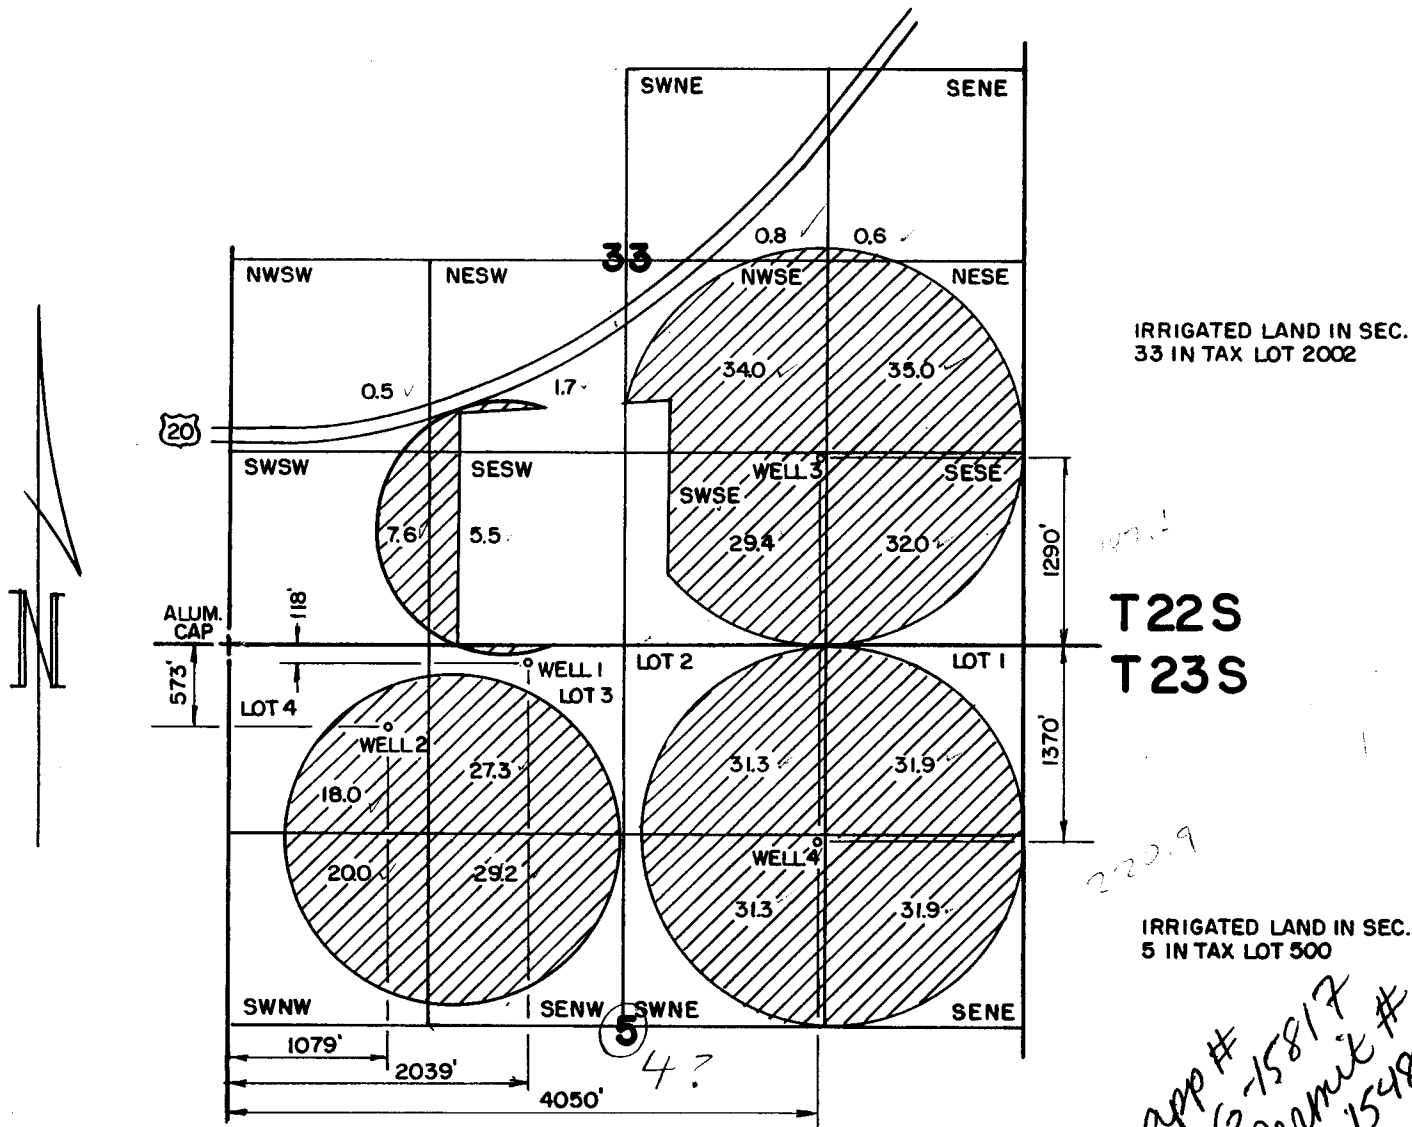

THE PURPOSE OF THIS MAP IS TO  
IDENTIFY THE LOCATION OF THE  
WATER RIGHT. IT IS NOT INTENDED  
TO PROVIDE INFORMATION RELATIVE  
TO THE LOCATION OF PROPERTY  
OWNERSHIP.

**RECEIVED**

AUG 12 2002

WATER RESOURCES DEPT.  
SALEM, OREGON

**RECEIVED**

AUG 01 2002

WATER RESOURCES DEPT.  
SALEM, OREGON

DON WELLS

## WATER RIGHT APPLICATION MAP

Scale: 1" = 1320'

Date: APRIL 2002

Job: 2009-02

Dsn:

Dm: CHRIS


Ckd:

**M.A.P's**

M.A. PALMER & SONS, INC.  
ENGINEERING & SURVEYING  
711 Ponderosa Village • Box 61  
Burns, Oregon 97720

Sht. No.

of 1

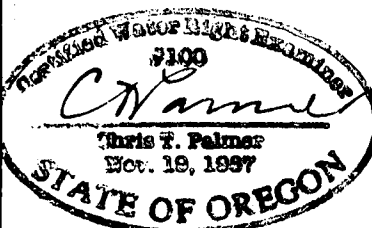

RENEW 1-1-2013