



SCALE: 1"=1320'

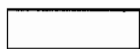

Lands irrigated from well under Permit number 15258.



Existing Mainline

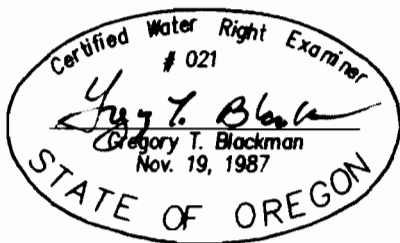

SUPERSEDING

February 23, 2007

FINAL PROOF MAP OF WATER RIGHTS FROM A NEW WELL

FOR
GRACE TORKELSON

BY

BAGETT - GRIFFITH & BLACKMAN
2006 ADAMS AVENUE
LAGRANDE, OREGON 97850

Application No. G- 15852

Permit Number G- 15485

NOTE: The preparation of this map was for the purpose of identifying the location of the proposed water right and has no intent to provide dimensions or location of property ownership lines. Location information shown hereon was furnished by the applicant.

RECEIVED

MAR 08 2007

WATER RESOURCES DEPT
SALEM OREGON