THIS MAP WAS PREPARED FOR ASSESSMENT PURPOSE ONLY.

SECTION 08 T.35S. R.07E. W.M.
KLAMATH COUNTY
KLAMATH BASIN
. Scale: 1" = 800'

35 07 08

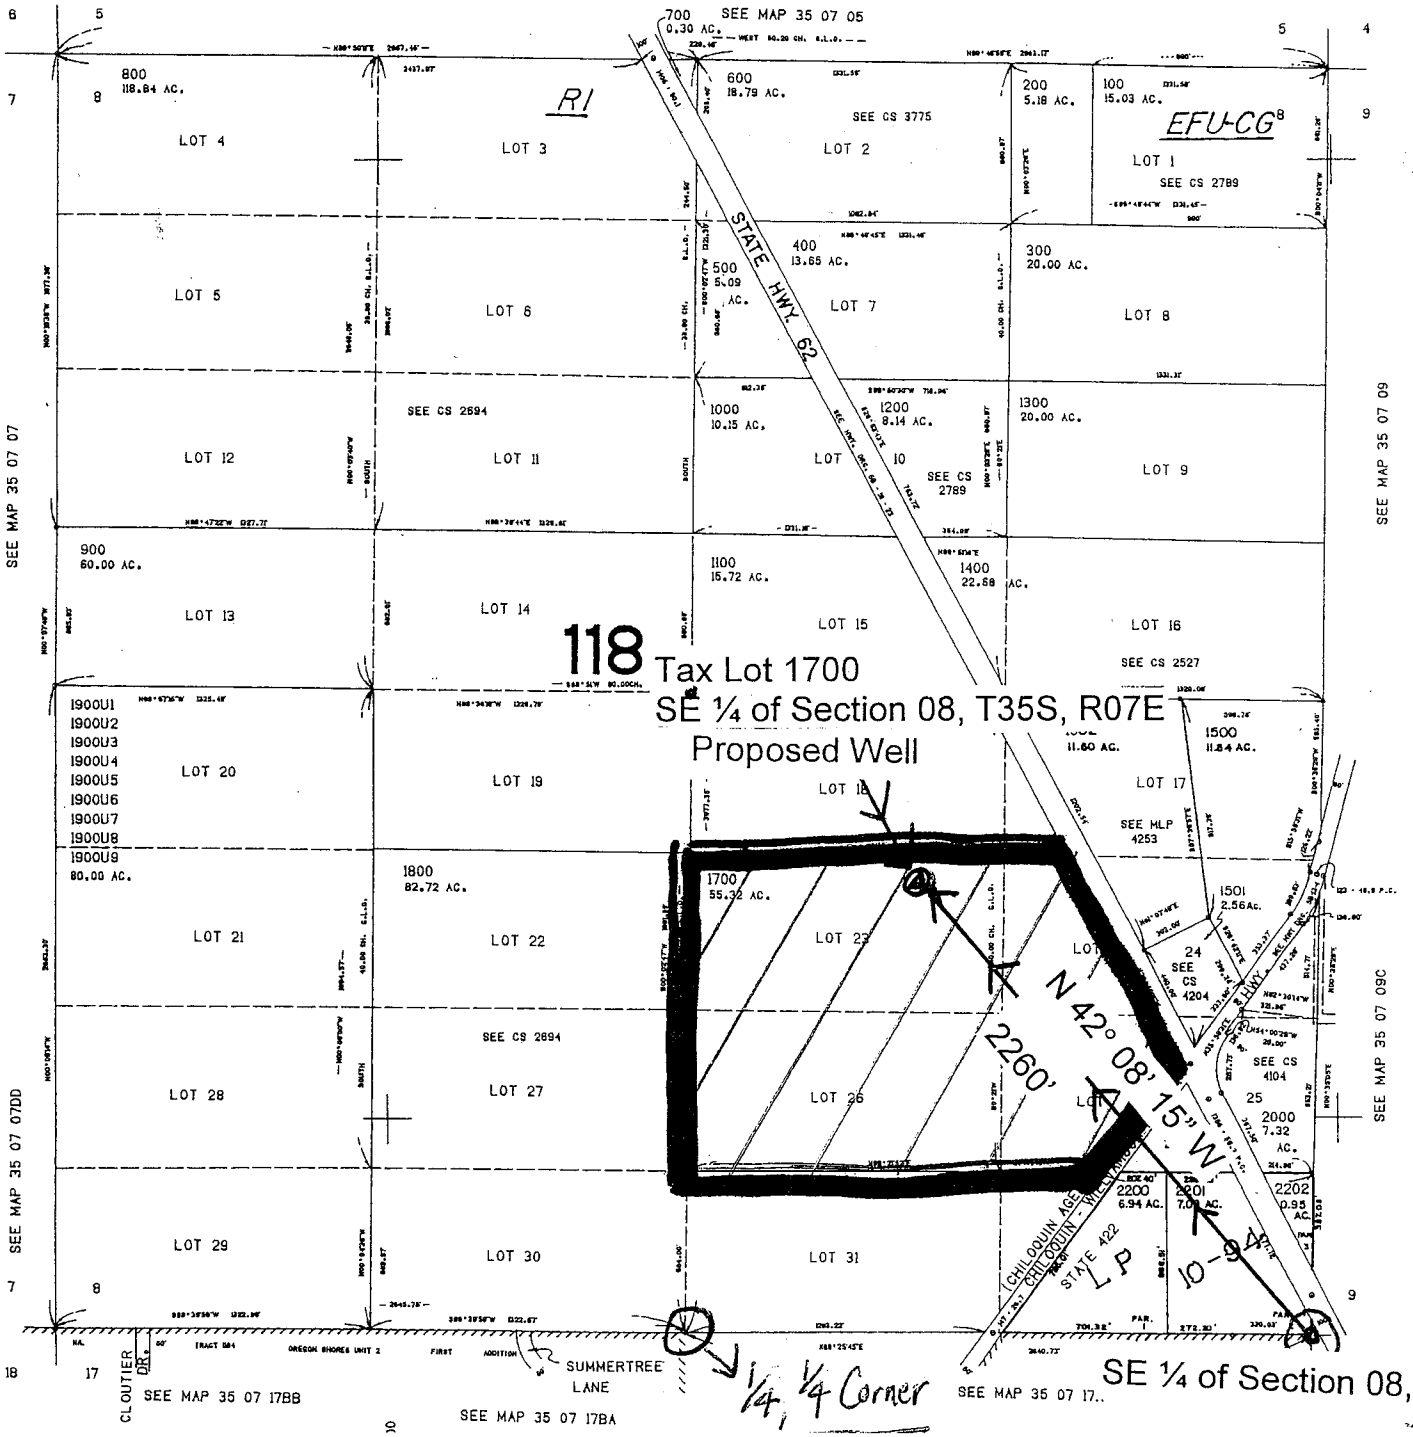

RECEIVED
SEP 3 0 2002
WATER RESOURCES DEPT.
SALEM, OREGON

324.000

app # G-15444
permit # G-15486

RECEIVED