


App # G-15938 Permit # G-15505

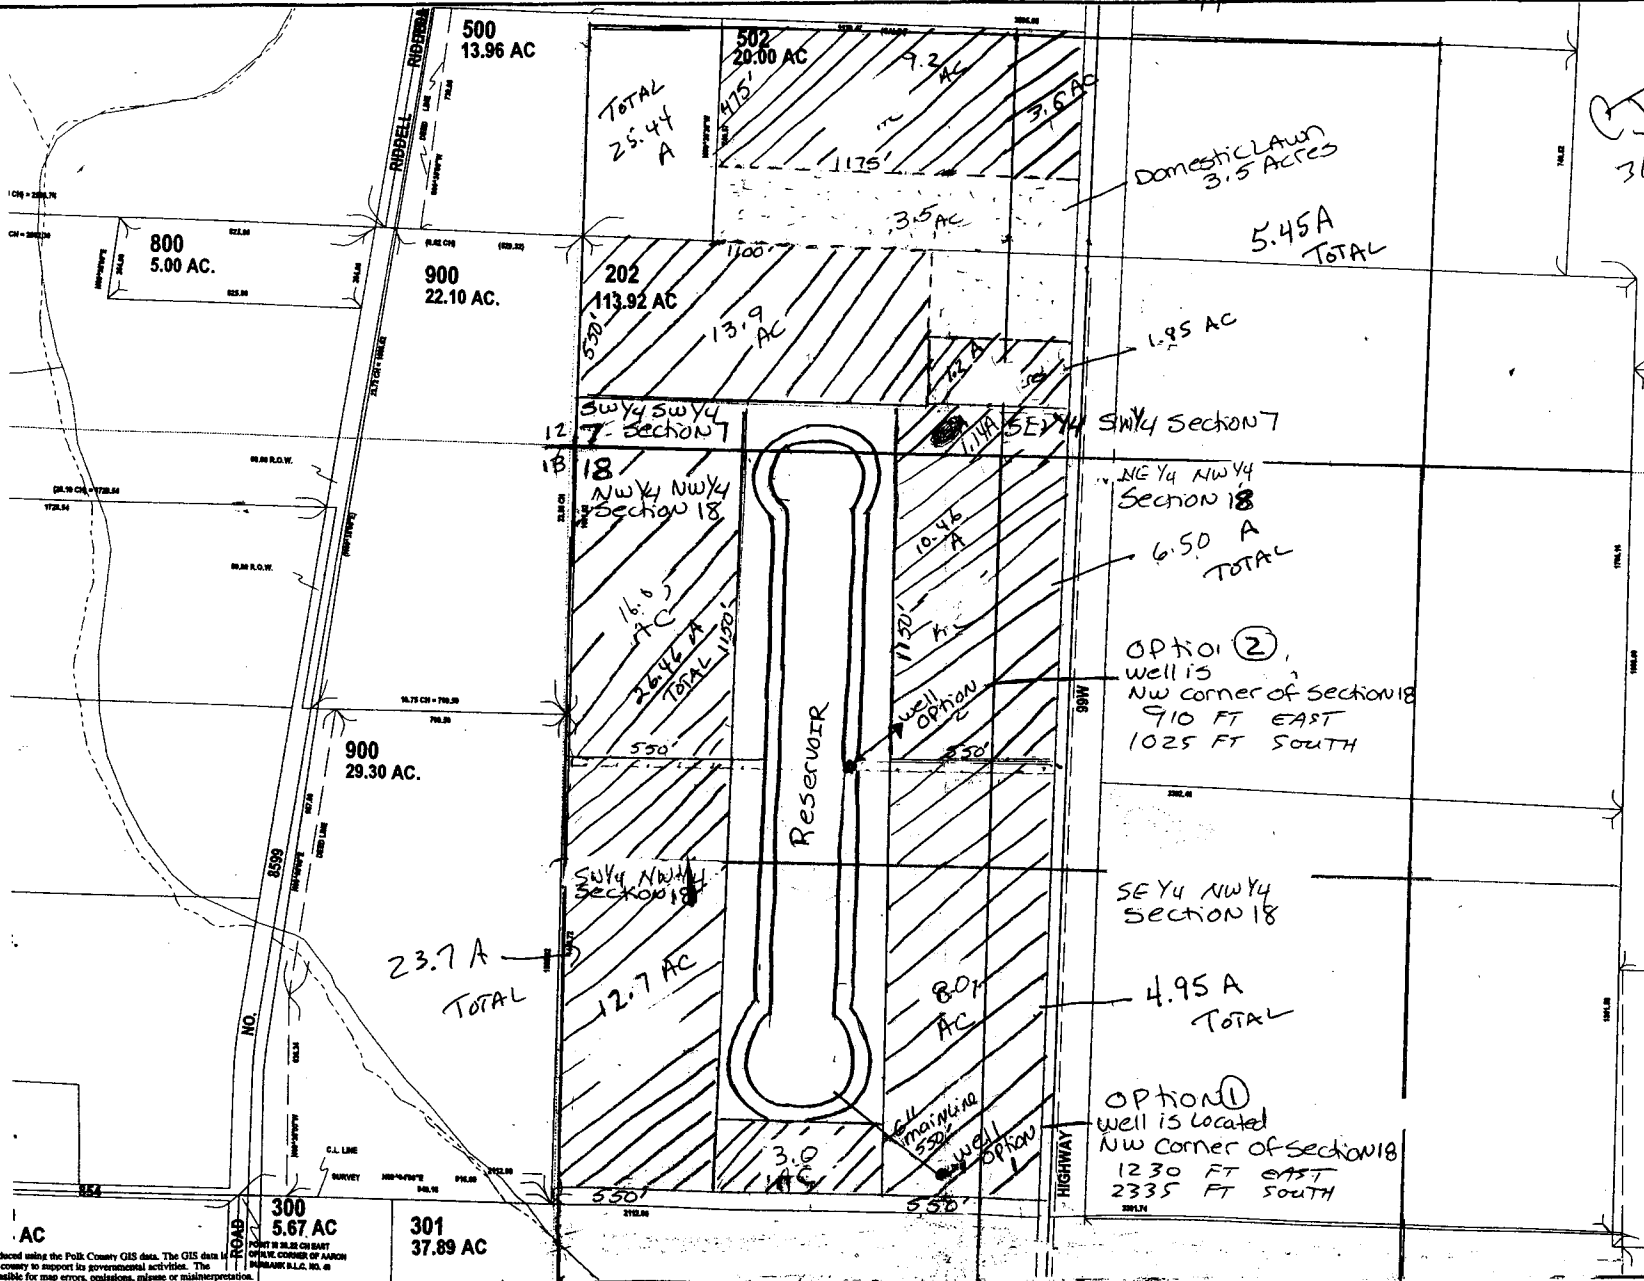

Polk County Map
Community Development


- LandMarks
- 1
- 2
- Roads
- OTHER
- CO-GRAVL
- STATEHWY
- CO-PAVED
- Section
- 1
- 5
- Taxlot
- Taxlot
- Taxlot Arrows
- Taxlot Boundary
- TaxMap Line
- 22
- 24
- 26
- 32
- 33
- 34
- 8
- TaxMap Sub Line
- TaxMap Ar
- Water

3/4/05

SW 1/4 Section of Section 7
T.8.S. R.4.W.
Polk County,
Oregon

NW 1/4 Section of Section 18
T.8.S. R.4.W.
Polk County
Oregon

Clay & Rhonda
Johnson

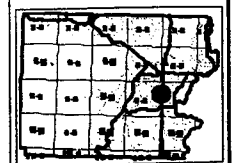

This map was produced using the Polk County GIS data. The GIS data is provided by the county to support its governmental activities. The county is not responsible for map errors, omissions, misuses or misinterpretation.

1 in. = 400 ft.