RECEIVED
NOV 29 2002
WATER RESOURCES DEPT
SALEM, OREGON

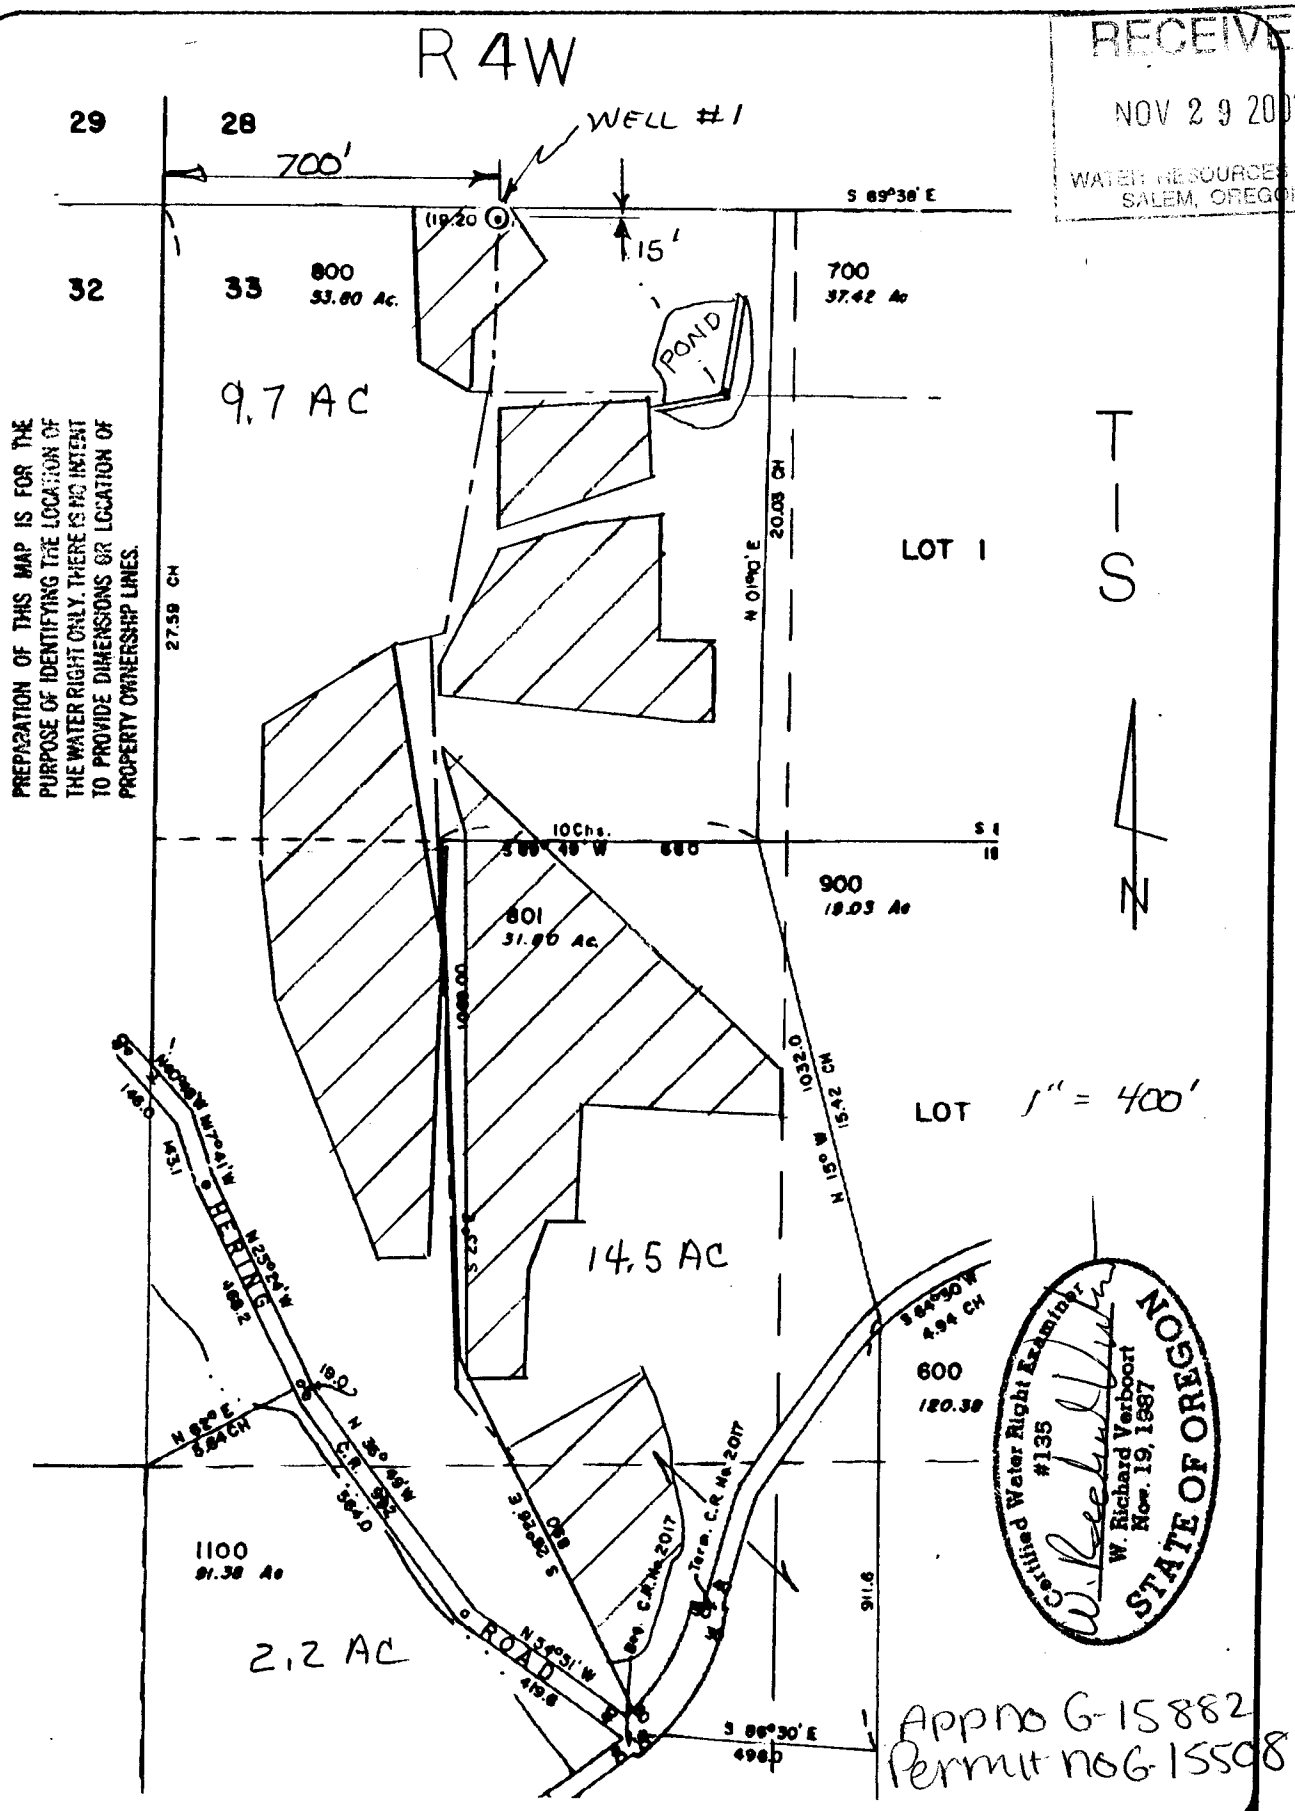

Appno G-15882
Permit no G-15508

VERBOORT ENGINEERING
AGRICULTURE · CIVIL · WATER RESOURCES
HILLSBORO, OREGON

	by	date
designed	RV	9/02
drawn		
checked	RV	9/02
drawing no.	02-A-06	
sheet no.	1/1	

CHERRY GROVE VINEYARDS, LLC
50045 S.W. PATTON VALLEY ROAD
GASTON, OREGON 97119