



Application Map

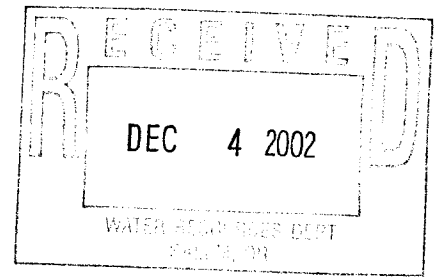

In the name of: D & D Frank Family, LLC.

T. 8S., R. 2W., W. M.

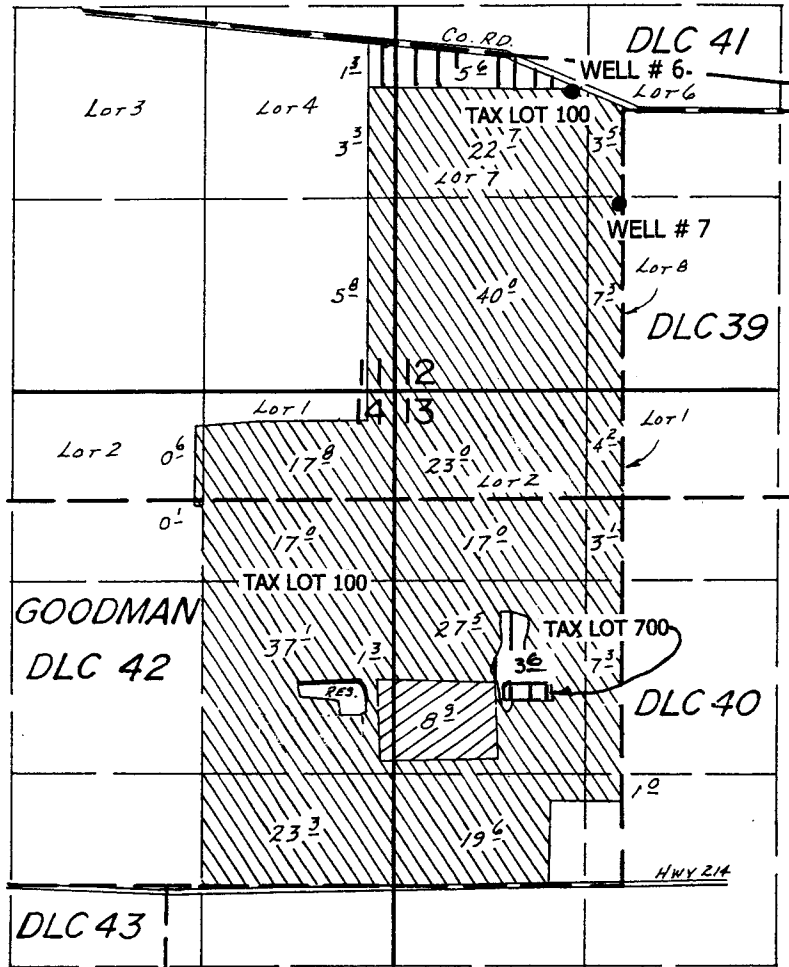

PRIMARY

Suppl. Cert. 65869

Suppl. Cert. 30627

Points of appropriation: Well # 6- 100' north & 350' west,
Well # 7- 625' south & 10' west, both from the NW corner DLC 39.

scale 4" = 1 mile

Don Knauer Consulting
PO Box 5416
Salem Oregon 97304
503-585-8474

App# G-15884
Permit# G-15517