


GILBERT AND PATRICIA HICE  
 953 FOOTS CREEK ROAD, GOLD HILL, JACKSON COUNTY, OREGON  
 T36 R4W S36 TL1000

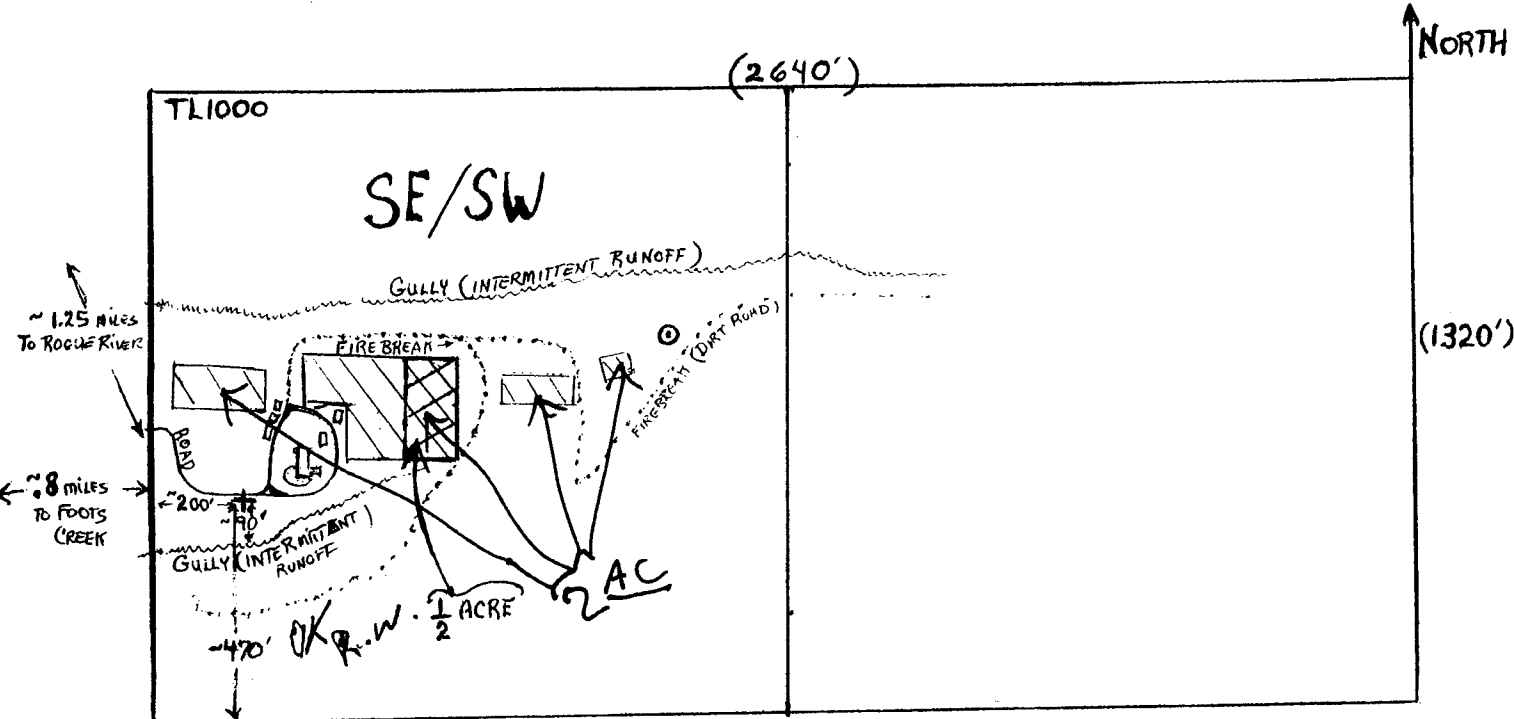

RECEIVED

JUN 26 2003  
 WATER RESOURCES DEPT.  
 SALEM, OREGON

- 1 INCH = 400 FEET  
 † = WELL  
 ○ = 1500 GAL CISTERN  
 🏠 = HOUSE  
 □ = STORAGE/WOODSHED  
 ▨ = PROPOSED IRRIGATED ACREAGE - 2 ACRES TOTAL  
 ▩ = AMENDED PROPOSED IRRIGATED ACREAGE AT 2.7 gal/min. *A.H. Hice*

RECEIVED  
 DEC 12 2002  
 WATER RESOURCES DEPT  
 SALEM, OREGON

NOTE: AS PER CONVERSATION (12/9/02), AS REQUIRED  
 PLEASE ADJUST COORDINATES. *A.H. Hice*

RECEIVED  
 NOV 29 2002  
 WATER RESOURCES DEPT.  
 SALEM, OREGON