


WORKSHEET
MAP

THIS MAP WAS PREPARED FOR
ASSESSMENT PURPOSE ONLY

COMPILED FROM
INFORMATION
PROVIDED BY
THE APPLICANT

SW1/4 SW1/4 SEC. 33 T38S. R09E. WM.
KLAMATH COUNTY
1"=400'

CANCELLED NO.
400

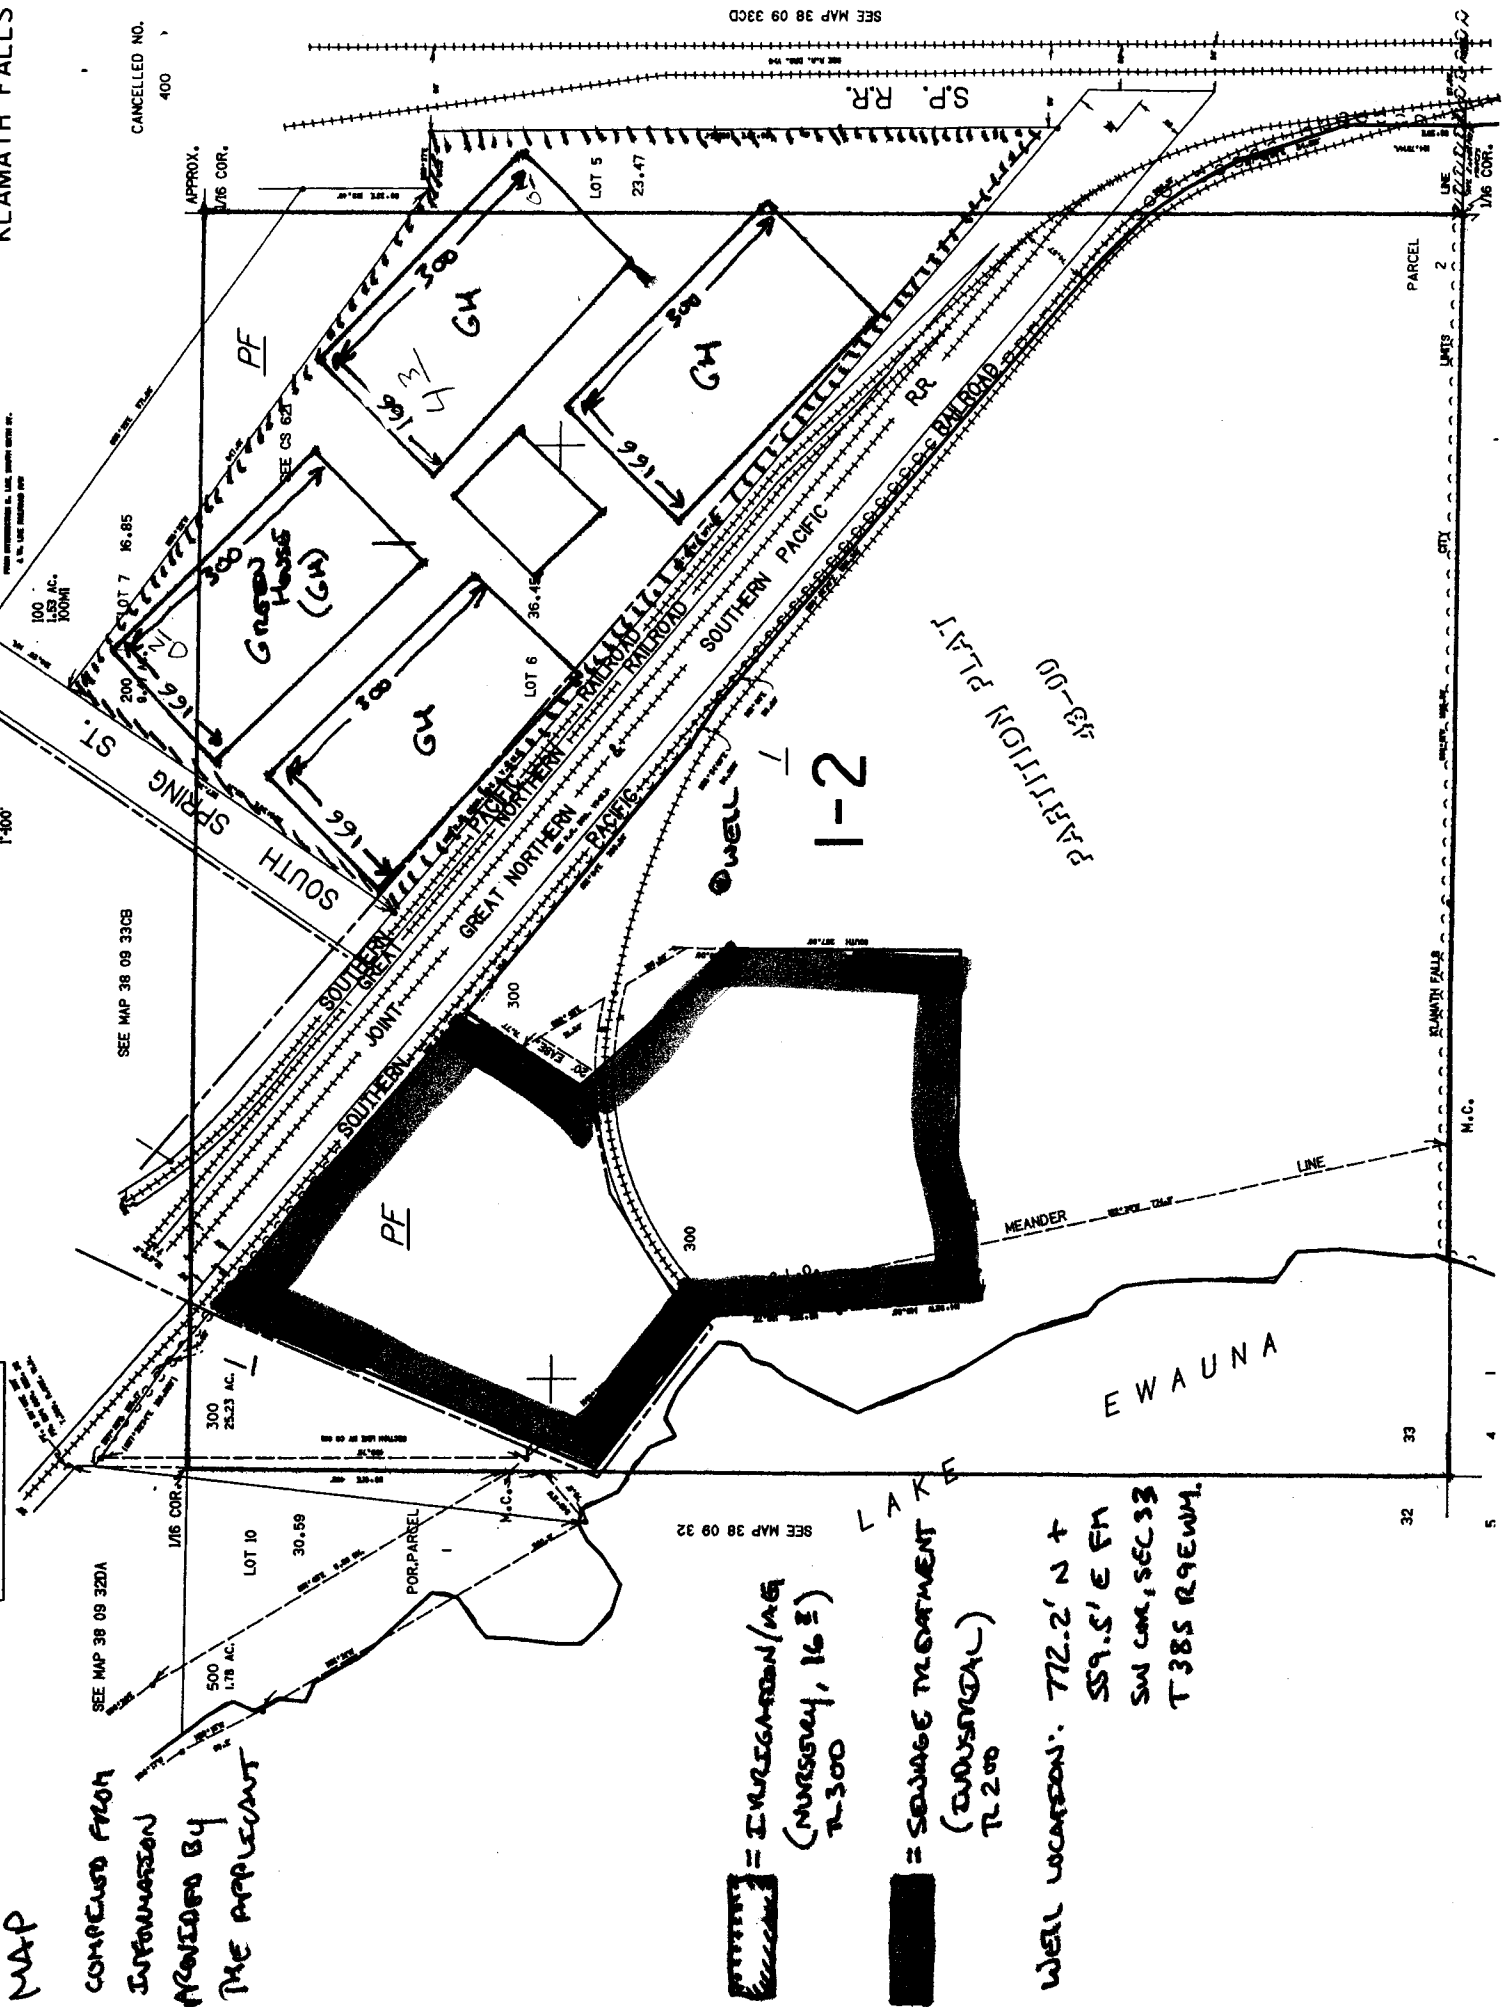

R.300

= SEWAGE TREATMENT
(INDUSTRIAL)
R.200

WELL LOCATION: 772.2' N +
559.5' E FM
SW COR, SEC 33
T38S R9EWM.

32 4 5

33 4 5

SEE MAP 38 09 33CD

SEE MAP 38 09 33CB

SEE MAP 38 09 32DA

SEE MAP 38 09 32

APPROX.
1/16 COR.

APPROX.
1/16 COR.

S.P. R.R.

PARTITION PLAT.
49-00

EWAUNA

PARCEL

UNITS

LINE

MEANDER

WATER TAIL

LINE

MEANDER

WATER TAIL

LINE