

SECTION 18 T.5S. R.1E. WM.  
CLACKAMAS COUNTY

1" = 400'


SEE MAP 5 IE 7

RECEIVED  
MAR 04 2002  
WATER RESOURCES DEPT.  
SALEM, OREGON

5 IE 18  
DEC 27 2002  
REGISTERED  
WATER RESOURCES DEPT.  
SALEM, OREGON

This map was prepared for  
assessment purpose only.

App# G-15900  
Permit# G-15335

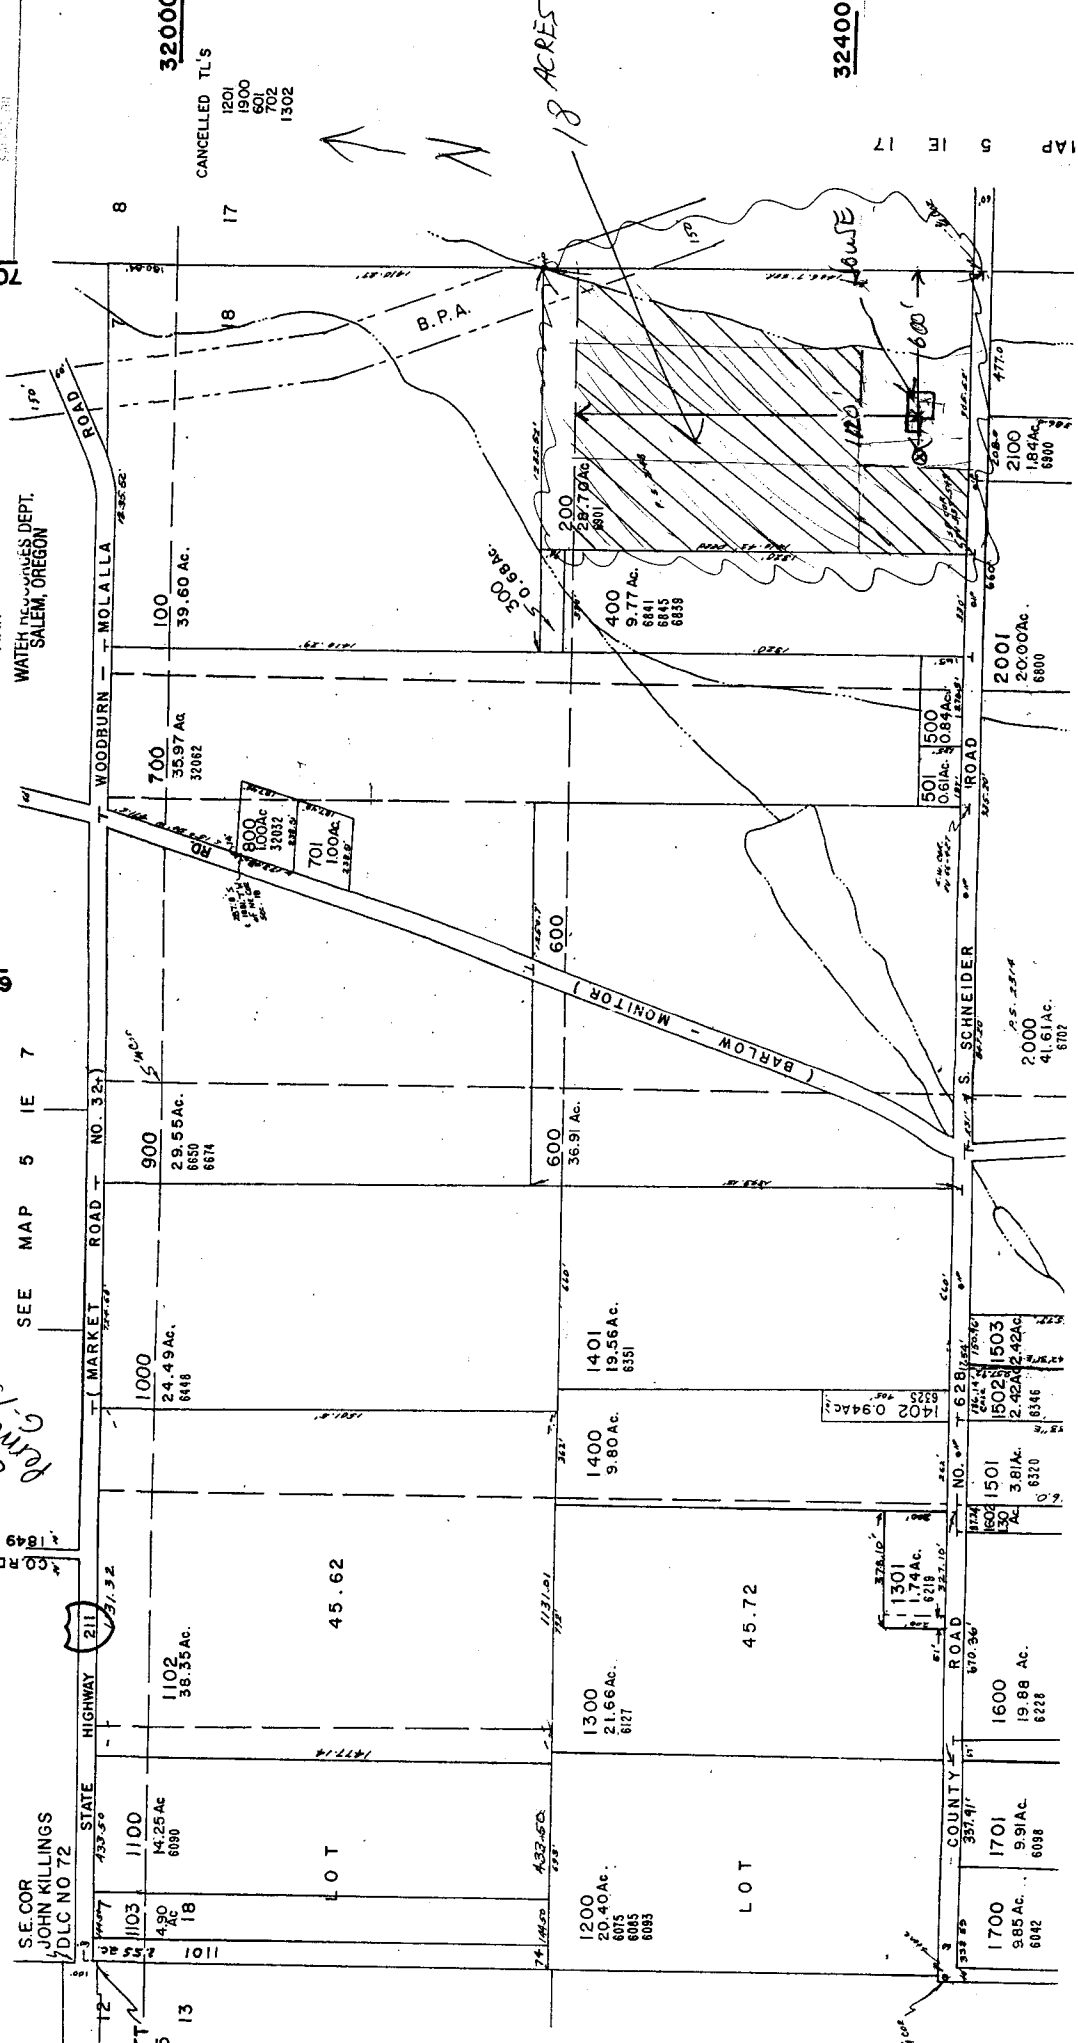


32400

32000

6000

LAP 5 IE 17

18 ACRES

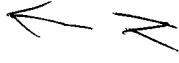

S.E. COR  
JOHN KILLINGS  
DLCL NO 72

STATE HIGHWAY 211  
433.52  
1102  
38.35 Ac.  
6090

1000  
24.49 Ac.  
6448

900  
29.55 Ac.  
6650  
6674

700  
35.97 Ac.  
32082

100  
39.60 Ac.

8  
17

1200  
20.40 Ac.  
6093  
6085  
6083

1300  
21.66 Ac.  
8127

1400  
9.80 Ac.

1401  
19.56 Ac.  
6351

9.77 Ac.  
6841  
6845  
6839

1600  
19.88 Ac.  
6228

1700  
9.91 Ac.  
6088

9.85 Ac.  
6042


2000  
41.61 Ac.  
6702

2001  
20.00 Ac.  
6600





