


Rudd Application Map


Township 2 S Range 39 E

App NO
G-16028
Permit NO
G-15541

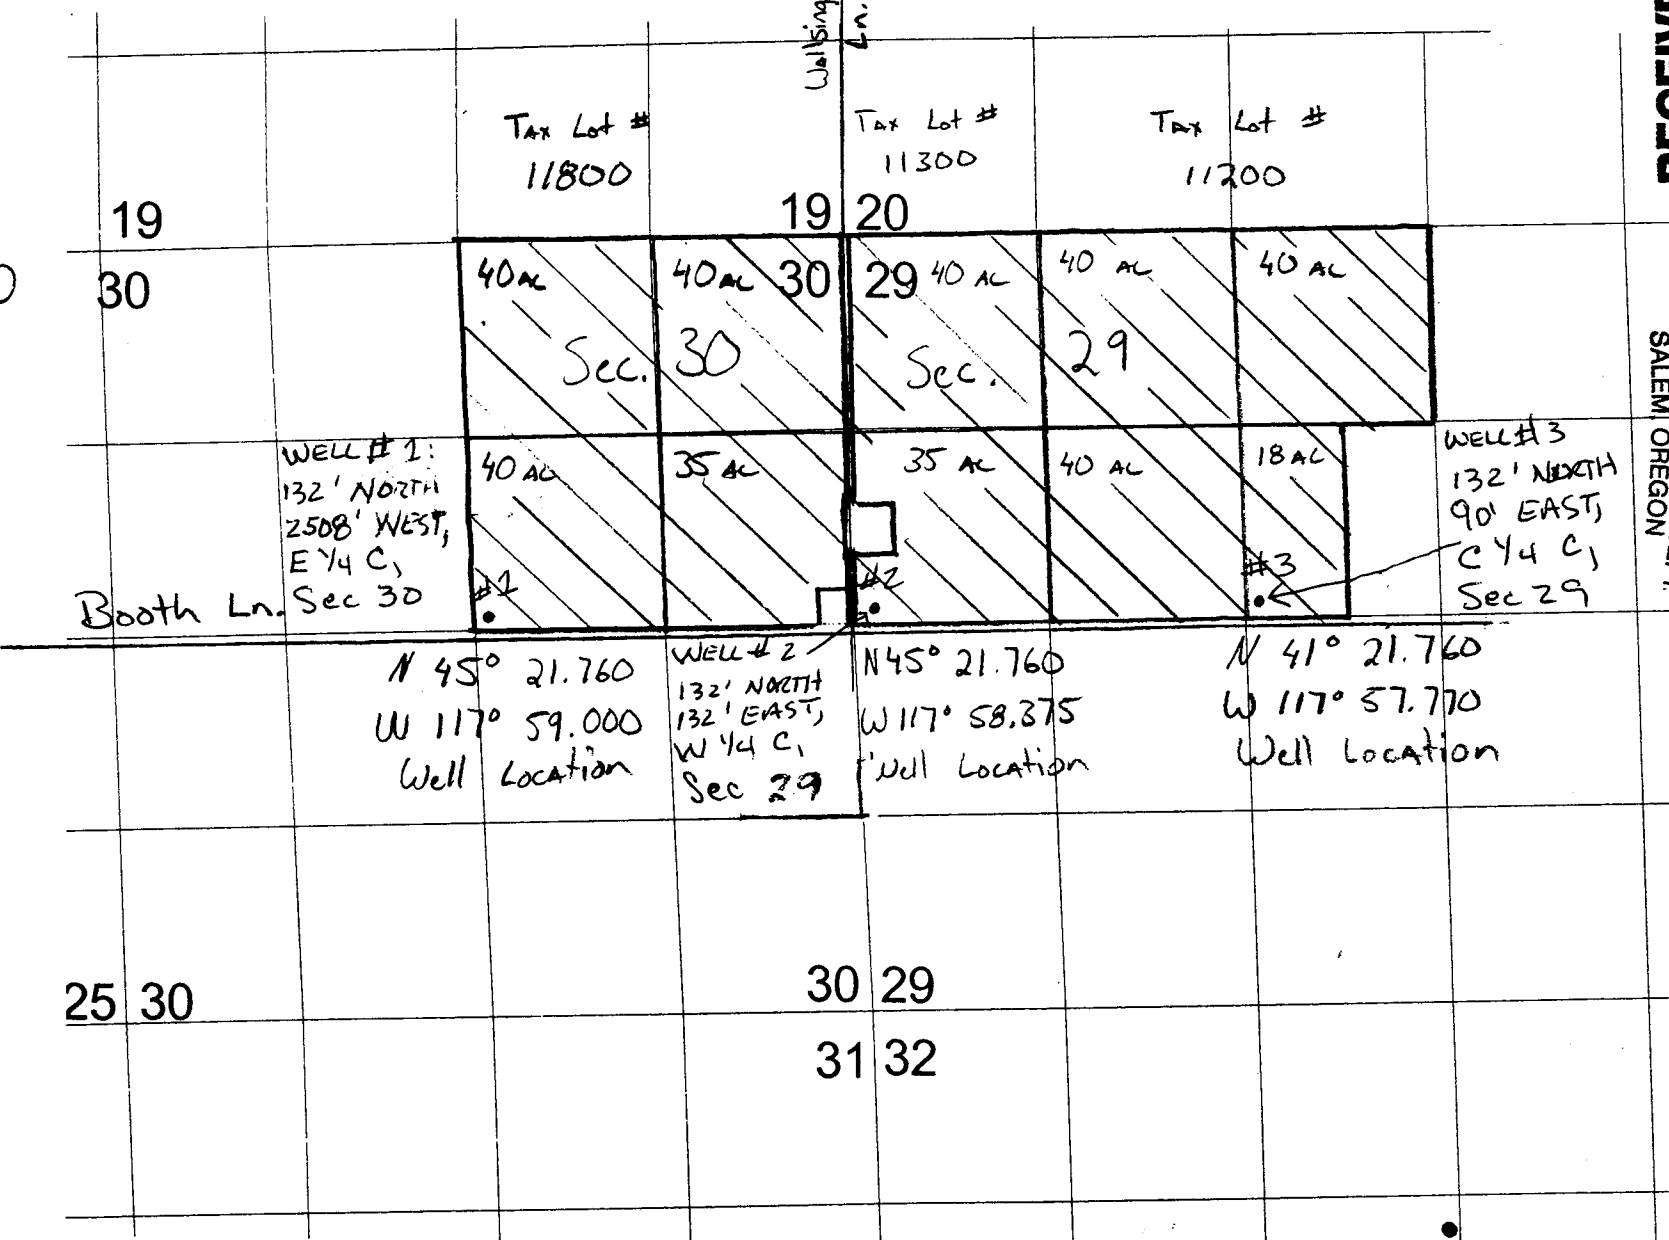

Lat/Long
Locations

Scale 1" = 1320'

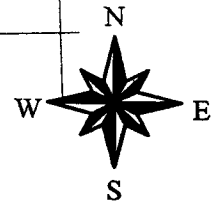

RECEIVED

MAY 02 2003

WATER RESOURCES DEPT.
SALEM, OREGON

WATER RESOURCES DEPT.
SALEM, OREGON

JUN - 5 2003

RECEIVED