

0 400
SCALE IN FEET

App No 6-1999
Permit No 6-1555

1"=800'

N
↑

SEE MAP 45 39

SEE MAP 45 39

SEE MAP 45 39

UNRECORDED

45 39 12

CANCELLED NO.
1001

45 39 12


RECEIVED

APR 30 2003

WATER RESOURCES DEPT
SALEM, OREGON

N
↑

* Attention Roger Wright:
In telephone conversation on 4-28-03
you indicated this map would be alright.
Dennis J. Smith

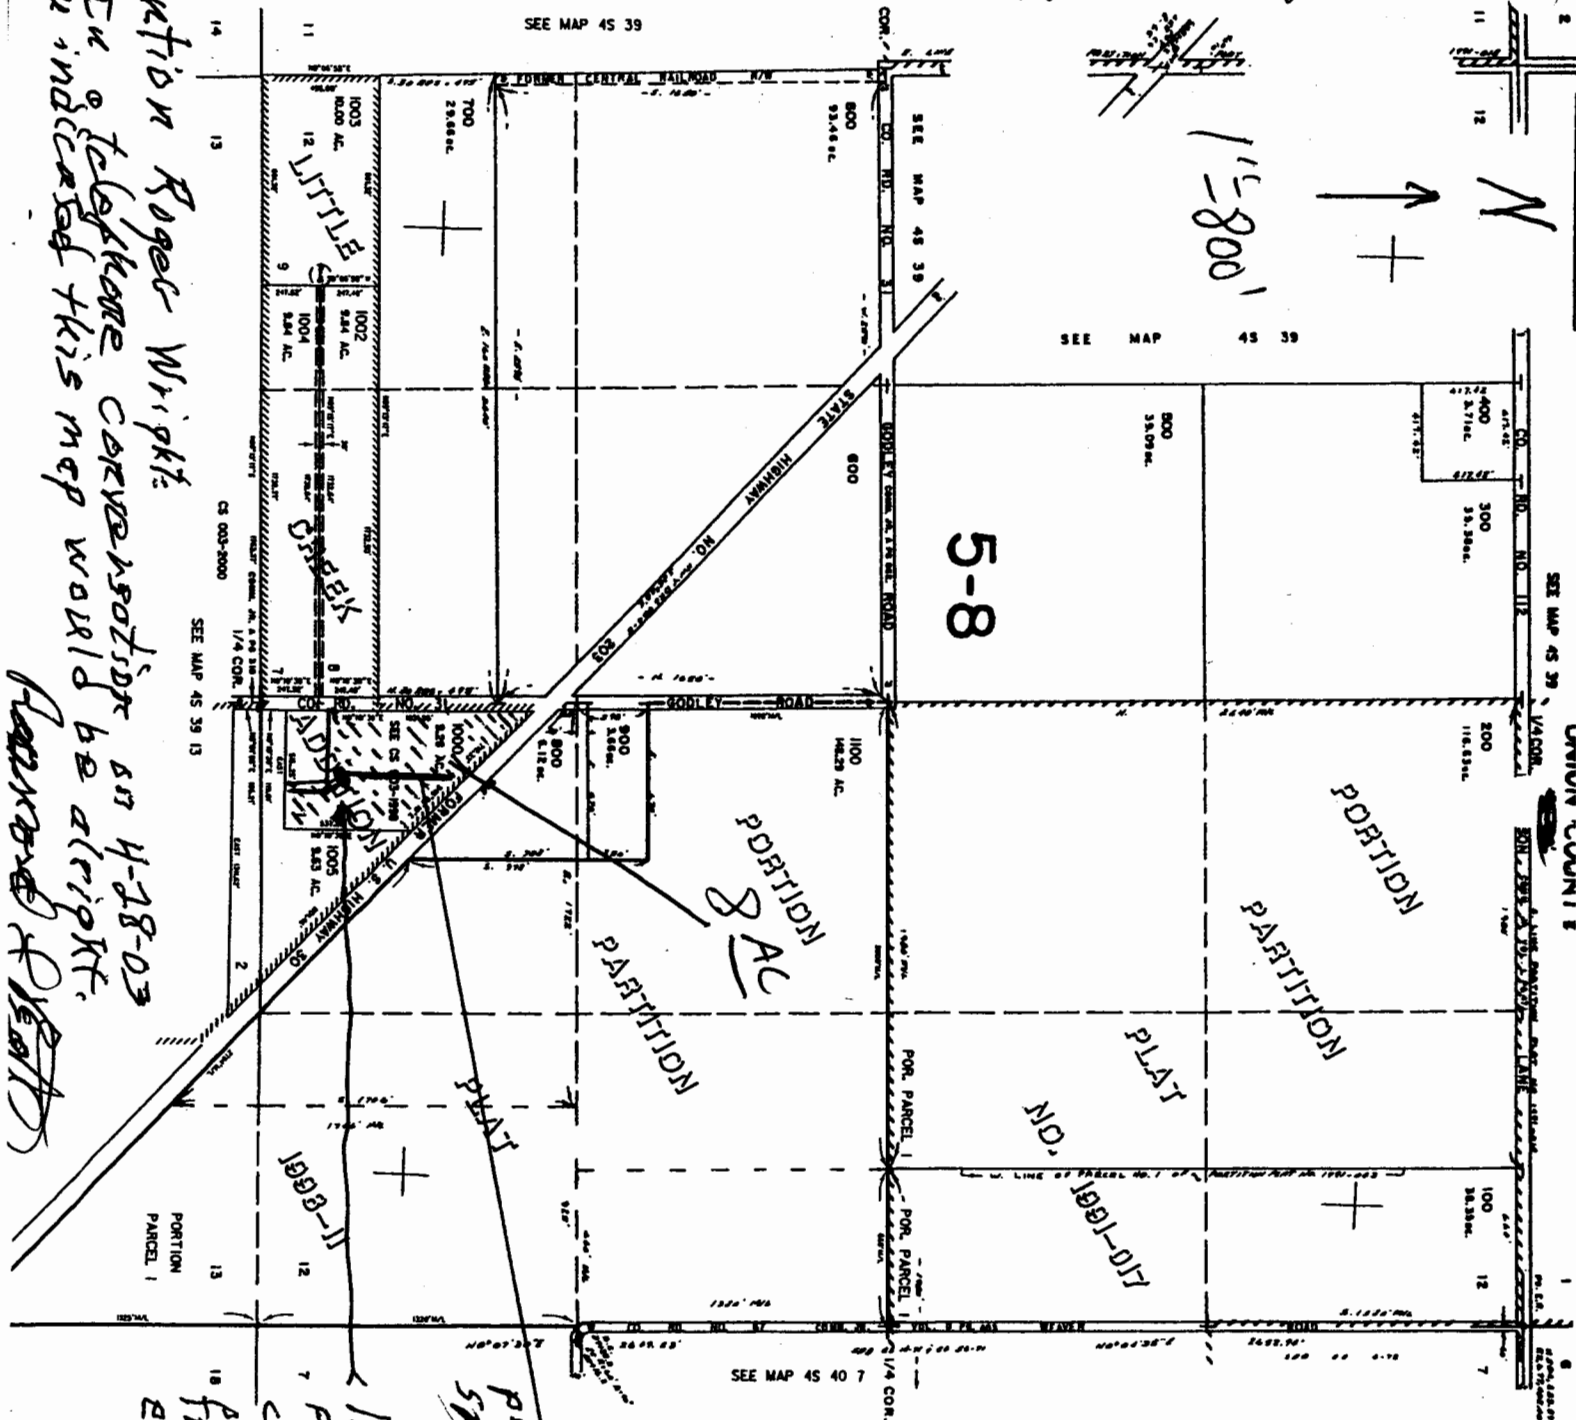

Main line from
proposed well for
sprinkling system

Location of well.
From 1/4 cor. (bottom
center of map) 415
feet north 310 ft
east.

Revised
3/14/01, SC
45 39 12