


N/4 CORNER SECTION 5 S 5

LAKEWOODS

32 33 4

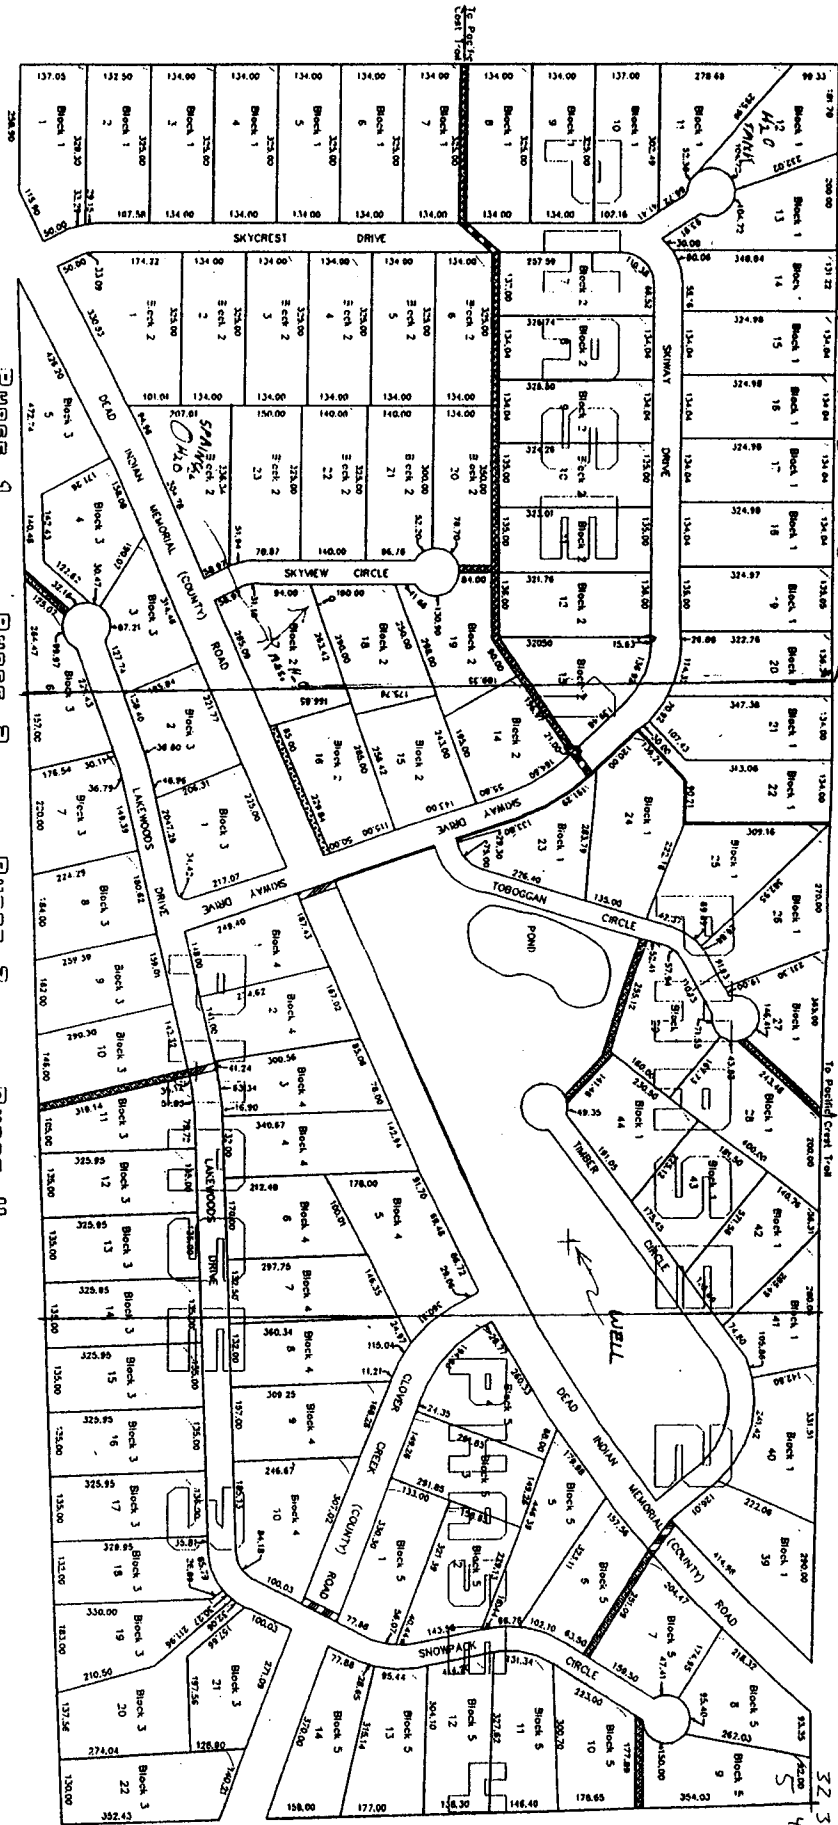


APPND G-15906
 PERMIT NO G-155534
 G-155555


WELL IS LOCATED:
 525 FT S &
 1180 FT W FROM
 NE CORNER SECTION 5

APP # G-15906

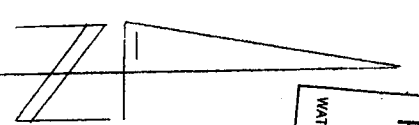

1" = 400'

RECEIVED
 JAN 07 2003
 WATER RESOURCES DEPT
 SALEM, OREGON

RECEIVED
 DEC 24 2002
 WATER RESOURCES DEPT
 SALEM, OREGON

 LAKEWOODS
 OREGON