


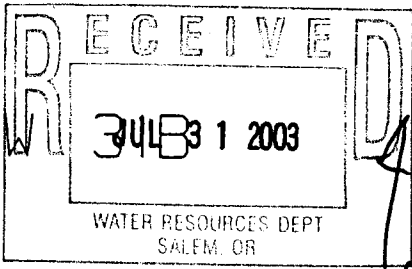

1390C  
530000




map 1 of 2

App G-16061  
Permit G-15558  
WORKING COPY

MILLER RD CR  
941.16  
511.5  
429.66  
16.5

1000 2300  
43717000

082 00 15 0

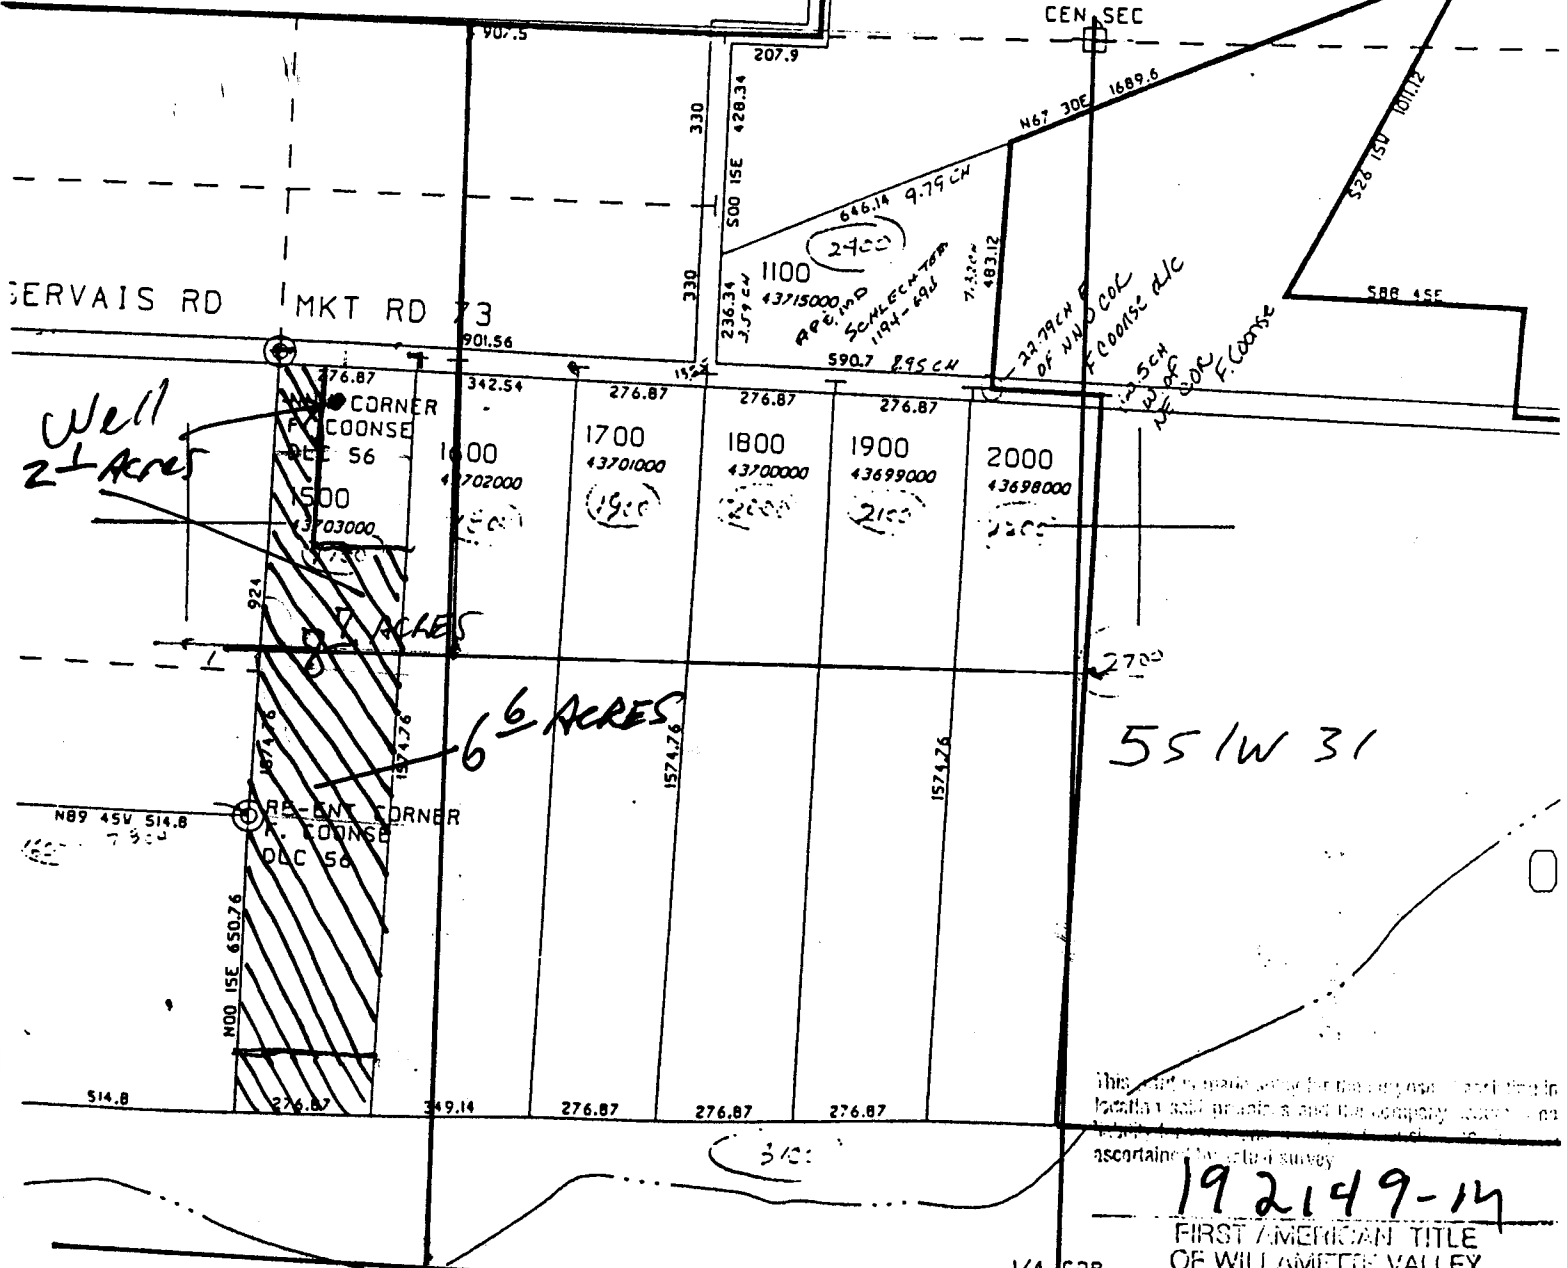

Well  
2 1/2 Acres

6 1/2 ACRES


SCALE 1" = 400'


192149-14

FIRST AMERICAN TITLE  
OF WILLAMETTE VALLEY  
200 LIBERTY, S.E., SUITE 100, SALEM

SEE MAP 06 1W 06

Well location: 100' S 120' E From Nly Nw Corner,  
Felix Coonse P.L.C.