RECEIVED
APR 6 2000
WATER RESOURCES DEPT
SALEM, OR

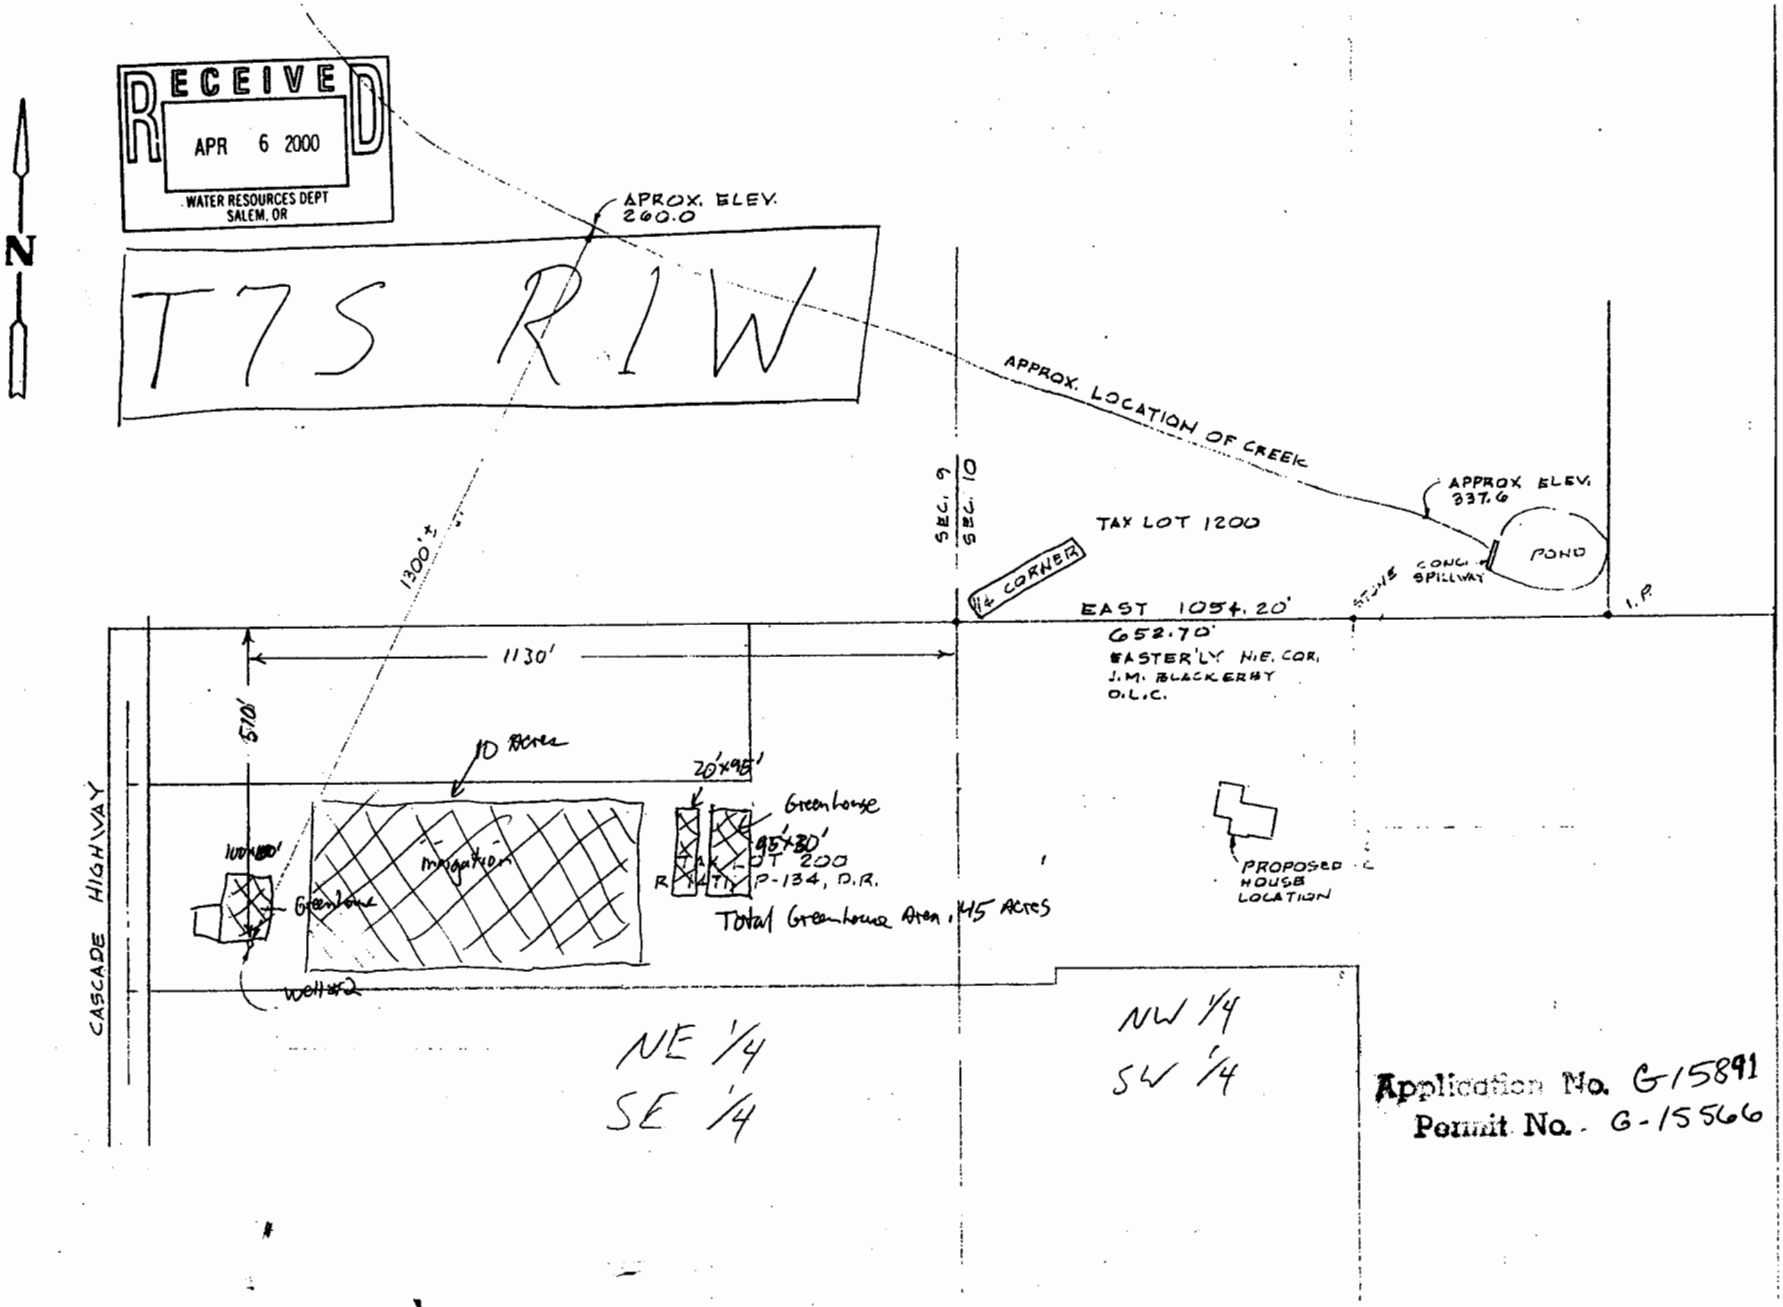

Application No. G15891
Permit No. G-15566