




T. 17 S. R. 19 E. W.M.
Sec 1-2

 Primary 49[±] Acres

 Supp 45[±] Acres

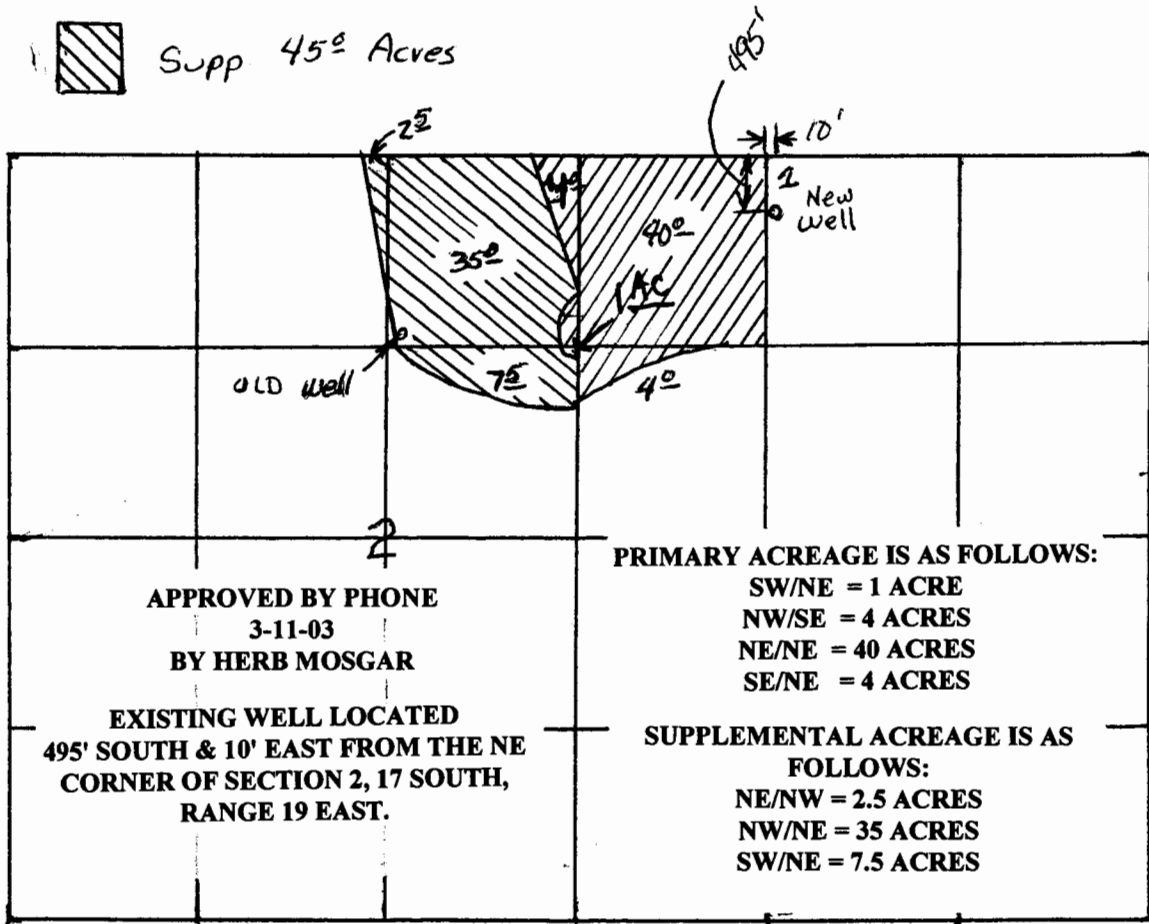

Scale: 4" = 1 mile

App# G-15946
Permit # G-15567

RECEIVED

MAR 10 2003

WATER RESOURCES DEPT.
SALEM, OREGON

Rance Kaster water rights map