


WORK COPY  
T1S R25E

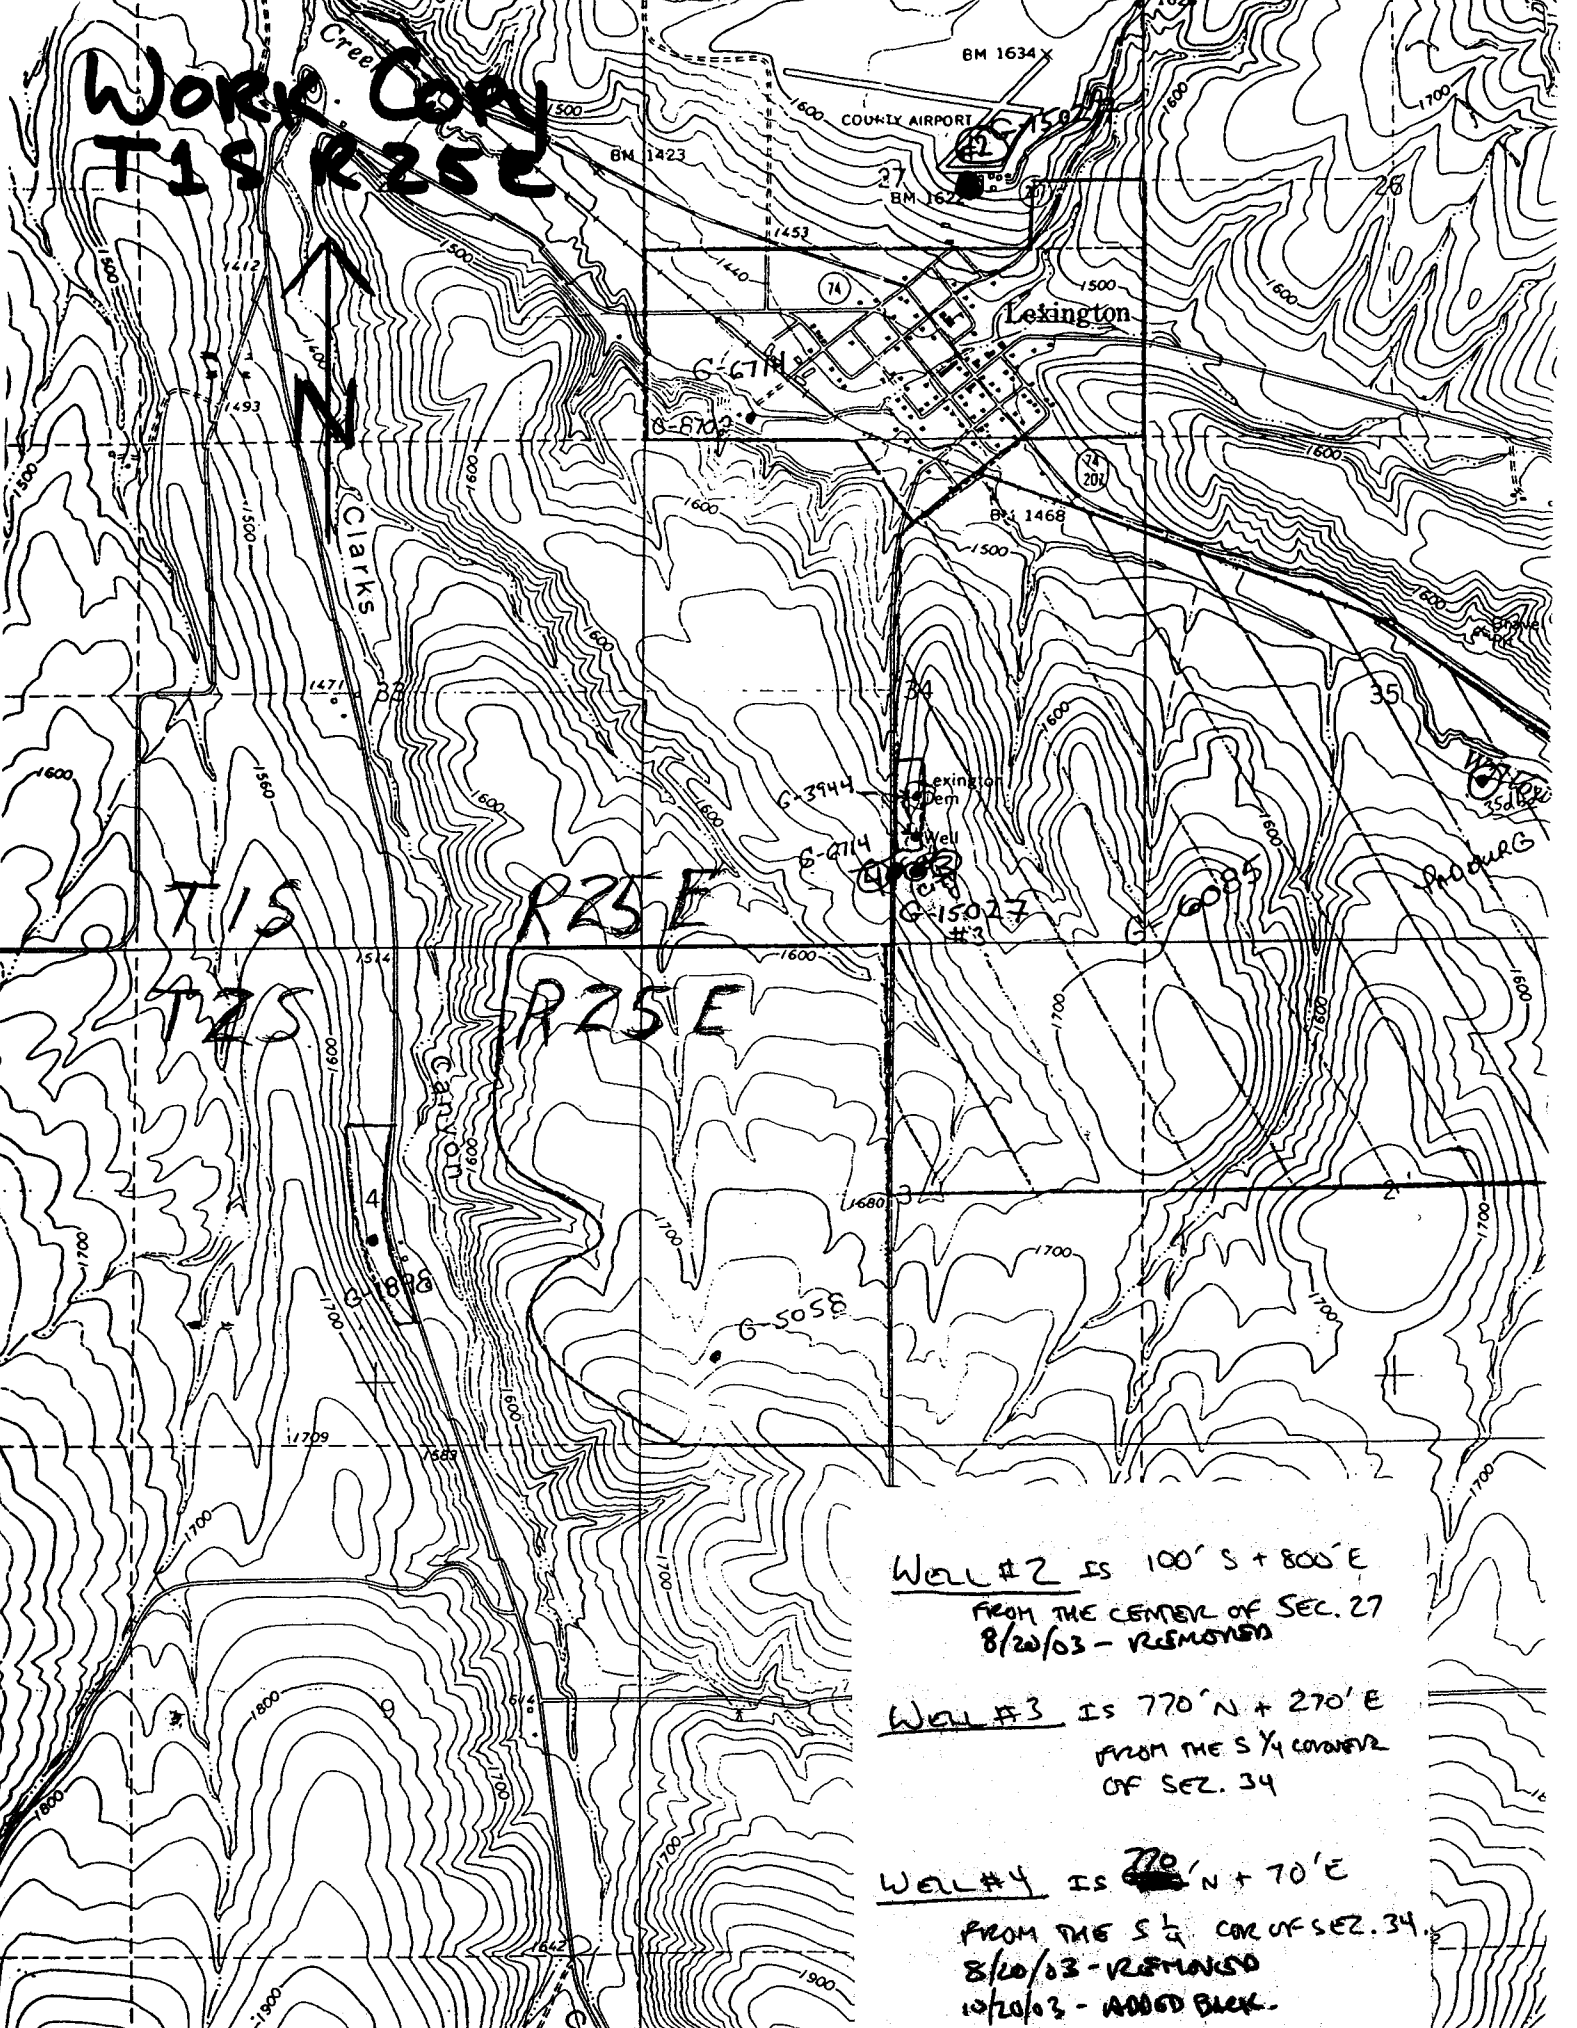

T1S  
T2S

R25E  
R25E

Well #2 is 100' S + 800' E  
FROM THE CENTER OF SEC. 27  
8/20/03 - REMOVED

Well #3 is 770' N + 270' E  
FROM THE S 1/4 CORNER  
OF SEC. 34

Well #4 is ~~770~~ 70' N + 70' E  
FROM THE S 1/4 COR. OF SEC. 34  
8/20/03 - REMOVED  
10/20/03 - ADDED BLACK.