

Legend

• Well
+++ MAINLINE

A
N


LINN COUNTY

LINN

WILLAMETTE RIVER

WILLAMETTE RIVER

COUNTY

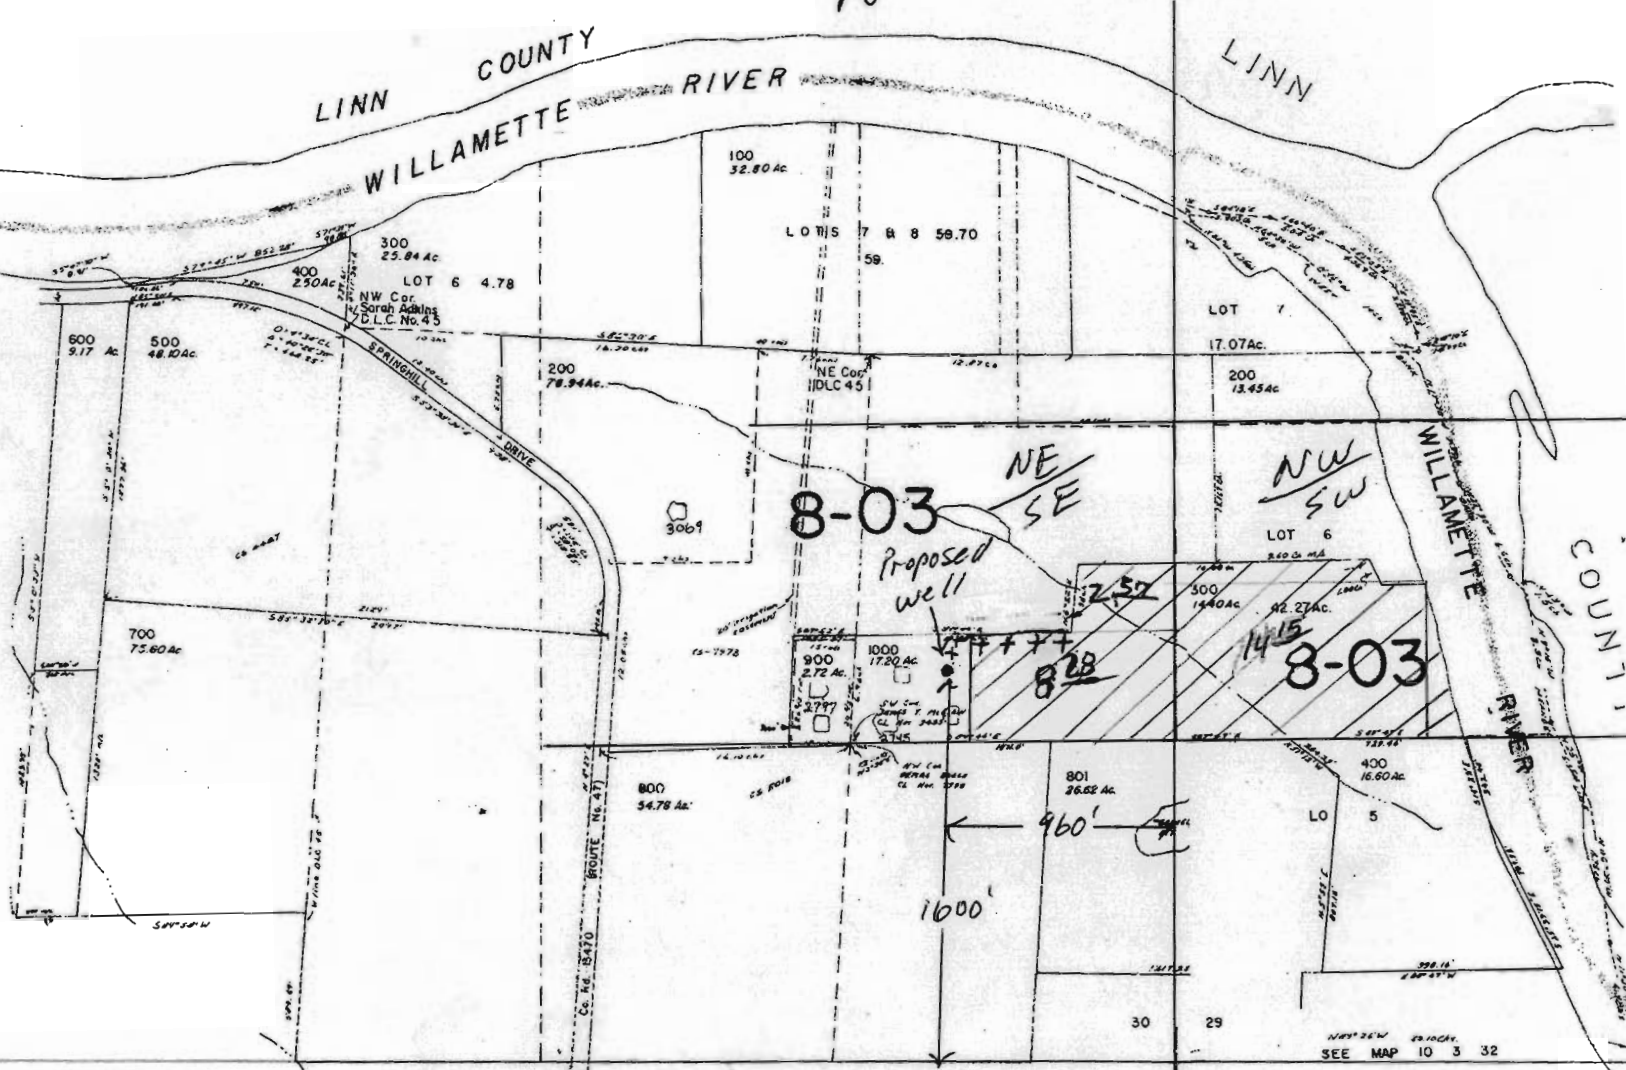

aprine G. 16063
Permit 9-15585

SEE MAP 10 4 25

SEE MAP 10 3 32

SEE MAP 10 3 31

25 30
34 31

30 29
31 32