


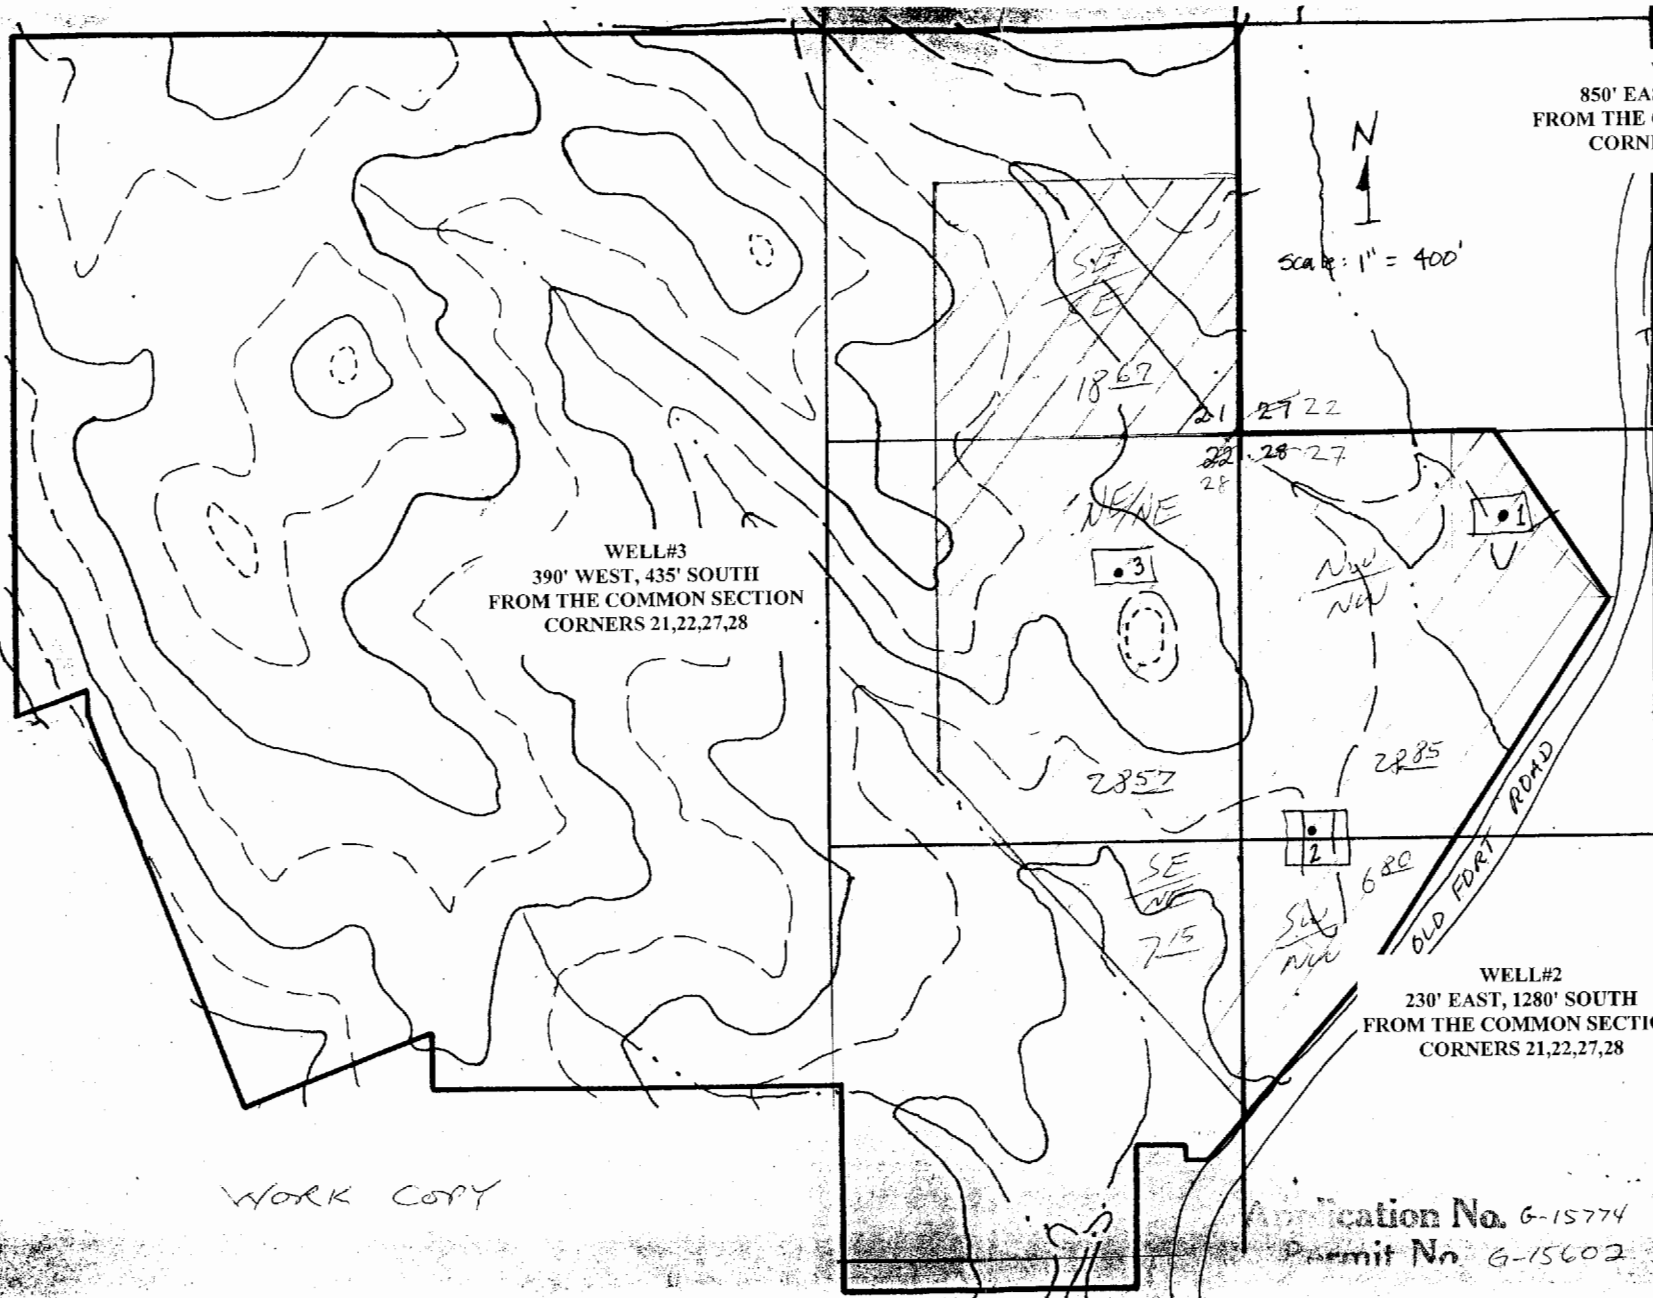

WELL#1
850' EAST, 275' SOUTH
FROM THE COMMON SECTION
CORNERS 21,22,27,28

MAP APPLICATION
TOM BOCCHI

Township 38S 9E SECTIONS 21,22,27,28

WELL #1 is located approx.
500' E/SE OF SECTION
CORNER 21, 27, 28 and 22.

WELL #2 is located approx.
1700' SOUTH OF SECTION
CORNER 21, 27, 28, and 22.

WELL #3 is located approx.
500' W/SW OF SECTION
CORNER 21, 27, 28 and 22.

WELL#2
230' EAST, 1280' SOUTH
FROM THE COMMON SECTION
CORNERS 21,22,27,28

AREA DRIP IRRIGATED



RECEIVED

JUN 06 2002

WATER RESOURCES DEPT
SALEM, OREGON

WORK COPY

Application No. G-15774
Permit No. G-15602

TO CITY OF