


# Map for: Don & Kathy Baird

Location: SW 1/4 & SW 1/4, SE 1/4 & SW 1/4, Section 20  
 SE 1/4 & SE 1/4, Section 20  
 T.4 S., R. 3 W., W.M., Yamhill Co., OR

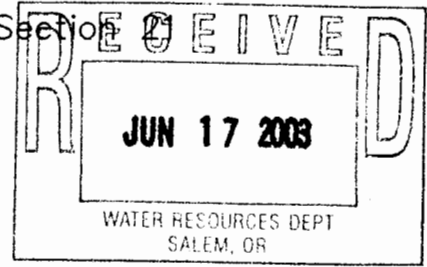


REFERENCE: File T-8923

Tax Lot: 3421 - 2500

## Legend


- = Property line
- = D.L.C. line
- = Section line
- = "40" line

- = area irrigated under Application G-2180 Permit G-2010, Cert. Volume 27 Page 35057 from new point of diversion
- = area irrigated under Application G-3954 Permit G-3710, Cert. Volume 31 Page 39553 from new point of diversion
- = area irrigated under Application G-2180 Permit G-2010, Cert. Volume 27 Page 35057 that will not change

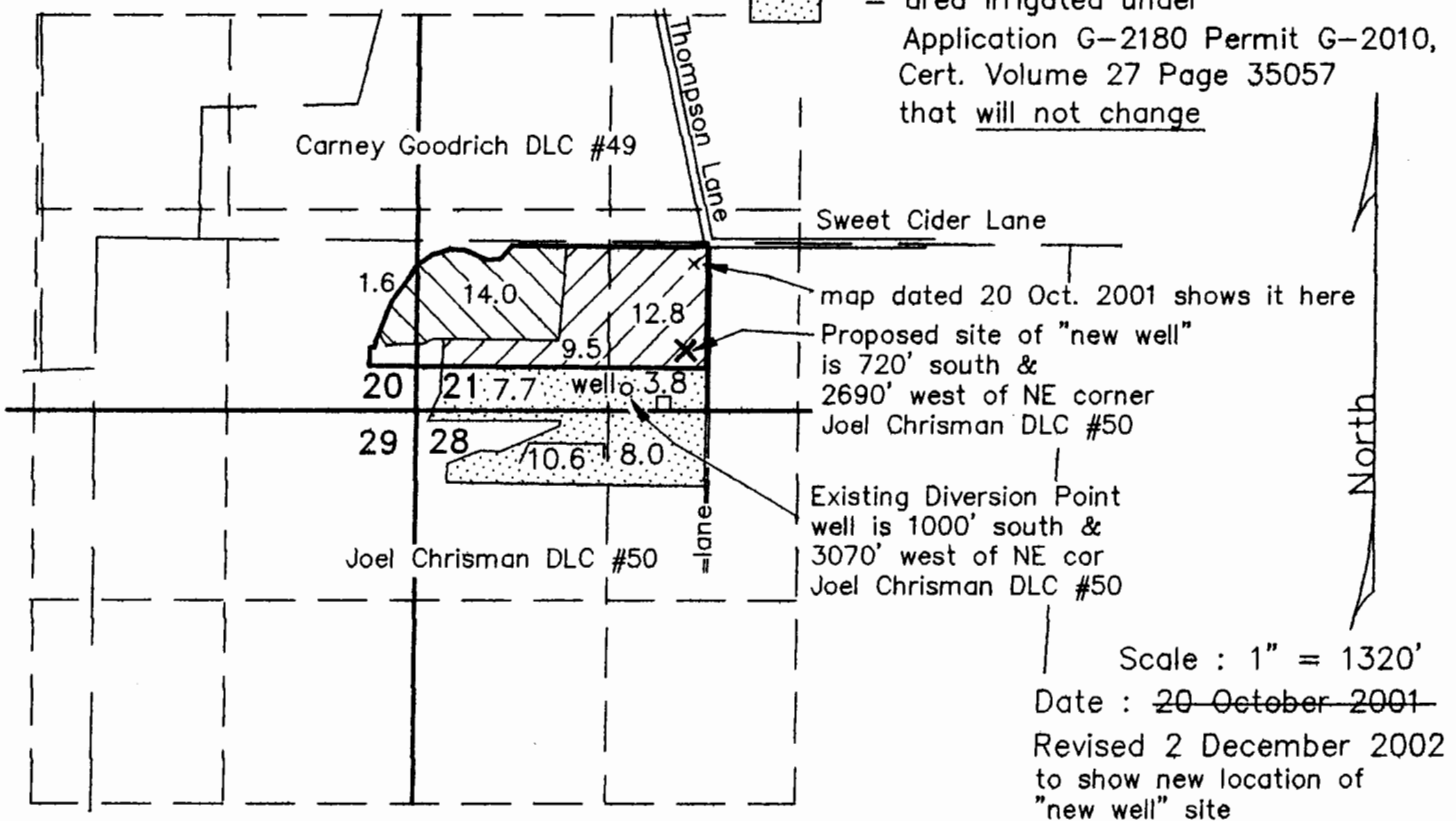

I certify that the information I have provided in this application is an accurate representation of the proposed water use and is true and correct to the best of my knowledge. This map is to be used for the purpose of identifying the location of water right only and is not intended to provide legal dimensions or locations of property ownership lines.

Matt Dunckel & Assoc.  
 3765 Riverside Drive  
 McMinnville, Oregon 97128  
 Phone : 472-7904

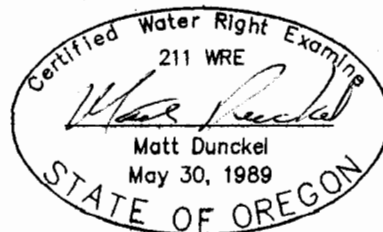

App No G-16035  
 Permit No G-15604