


WORKING FARM BASIS UPON INFORMATION SUPPLIED BY THE APPLICANT

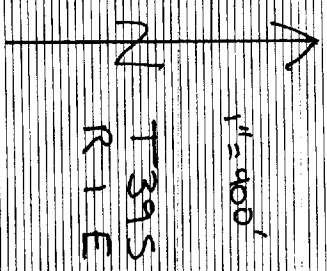

WELL IS LOCATED 1370'S & 130'E FROM NW COR, SEC 24

IRRIGATED ACRES BY QUARTER SEC

- Sec 24 NW/4 = 1.5 Acres
- Sec 24 SW/4 = 2.5 Acres
- Sec 23 SE/4 = .5 Acres
- Sec 23 NE/4 = 1.5 Acres
- Sec 24 SW/4 = 1.0 Acre
- Sec 24 SW/4 = 1.0 Acre

RESERVED LANDS  
 UP - UPPER PART - 1400' S & 230'E  
 FROM NW COR, SEC 24  
 LP - Lower Part - 1380' S & 300'E  
 FROM NW COR, SEC 24

QUARTER CORNER COMMON TO SEC. 23 & 24

1157.31'

1370 S  
 130 E  

